



REC'D 9-24-96, SYM BK

MORNING SITE ADDITION NO 2
CABINET "A" SLIDE 239

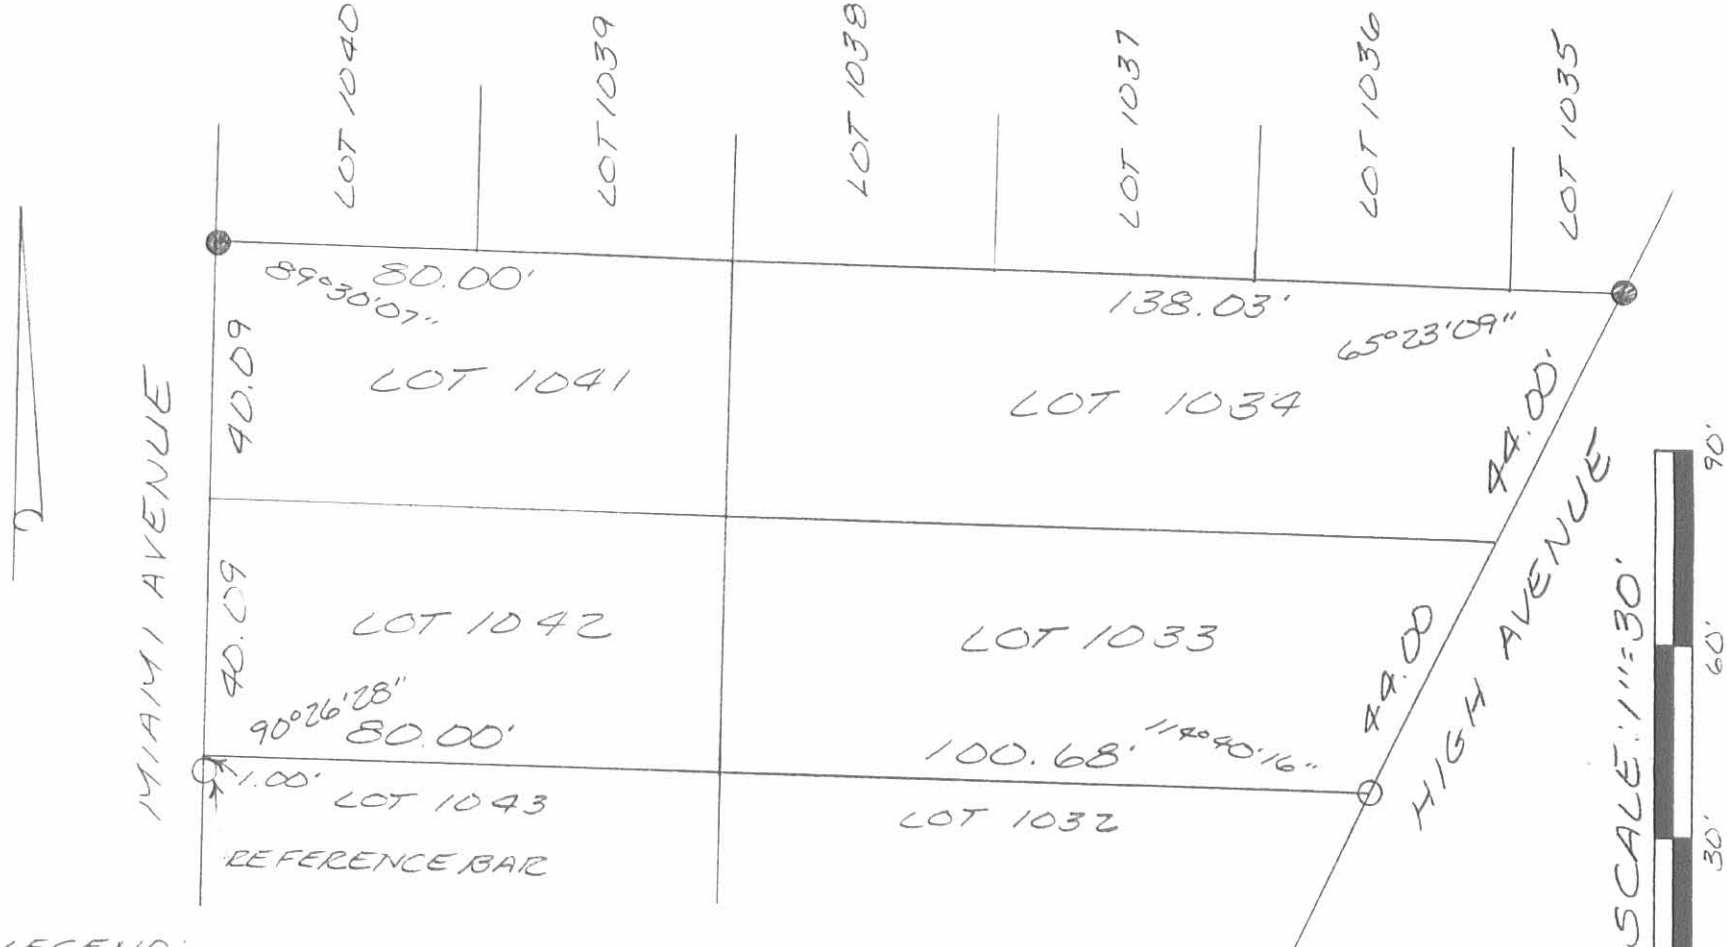

LEGEND:
 ○ = 5/8 INCH IRON BAR FOUND
 ● = 5/8 INCH IRON BAR SET

SURVEY OF LOTS 1033, 1034, 1041 AND 1042
 OF MORNING SITE ADDITION NO. 2
 IN RUSSELLS POINT, SECTION 1, TOWN 7 S.,
 RANGE 8, LOGAN COUNTY, OHIO FOR
 KEVIN ARNDTS ON
 SEPTEMBER 23, 1996
 (WASHINGTON TOWNSHIP)

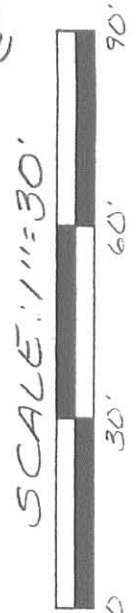

Leslie H. Geeslin
 LESLIE H. GEESLIN
 RUSHSVLVANIA, O
 (513) 468-2793

INDEXED ON MAP
 9094 1P