



McCoy  
Russell's Pt

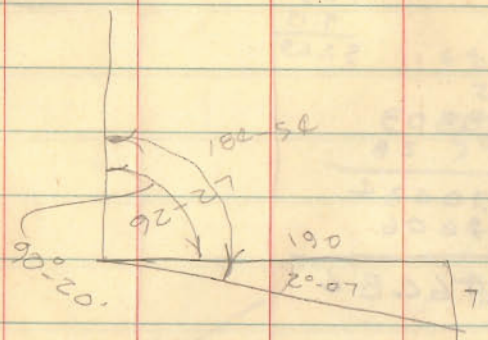

$$\begin{array}{r}
 190 \sqrt{103684} \\
 \underline{7.00000} \\
 370 \\
 \underline{1300} \\
 1140 \\
 \underline{1600} \\
 1520 \\
 \underline{800} \\
 760
 \end{array}$$

INDEXED ON MAP  
9617

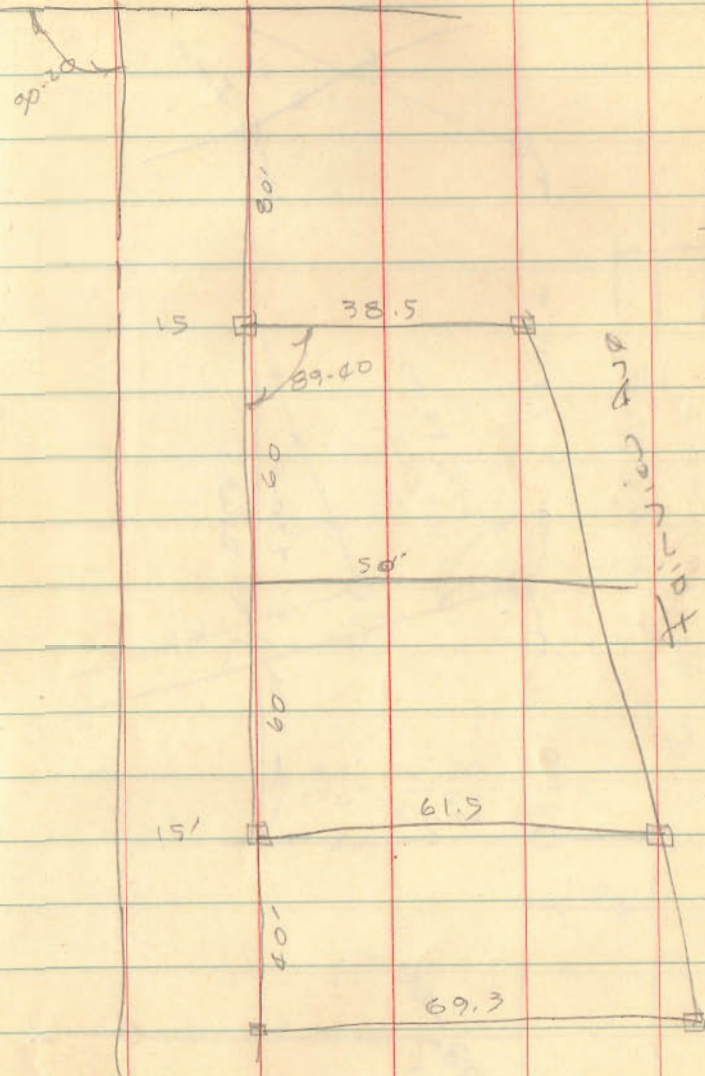

$$\begin{array}{r}
 38.5 \\
 15 \\
 \hline
 53.5
 \end{array}$$

$$\begin{array}{r}
 61.5 \\
 15 \\
 \hline
 76.5
 \end{array}$$

$$\begin{array}{r}
 69.3 \\
 15 \\
 \hline
 84.3
 \end{array}$$