

Graham Survey.
Starks Township
V.M.S. 12276


Cottage site

H.E. Wise Addition.

April-1924

39

Wright
Mr Graham

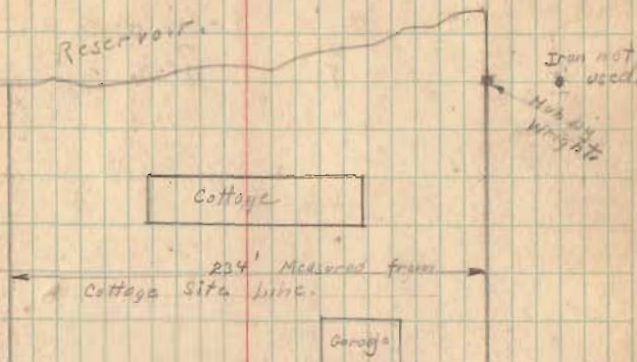

78

INDEXED ON MAP

