

Road Near Andrews Farm Stokes

Road # 89

Note that stone B is not in line
between A and C. This is over
about 2' from A.C.

Sec. 7

B is 15' from present fence.
No measurements were made
between stones.

See Road Survey Book 559 Page 6

137

INDEXED ON MAP

Sec. 18


June-17-1923

Made

Wright
Ed. Cox

44

Road 86

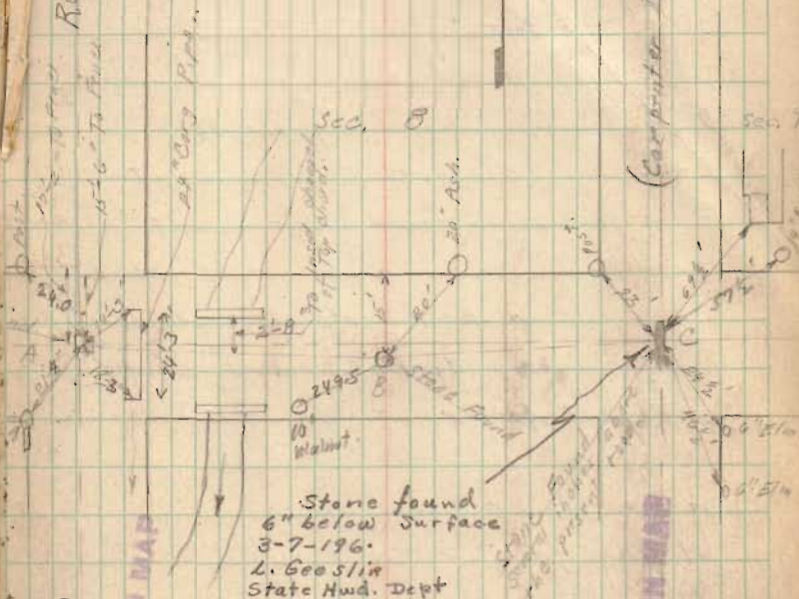

138

INDEXED ON MAP

Sec. 17

139

INDEXED ON MAP

Sec. 16