


Surveyed for -
Ulysses G. Keith

Sept. 27. 1911

912

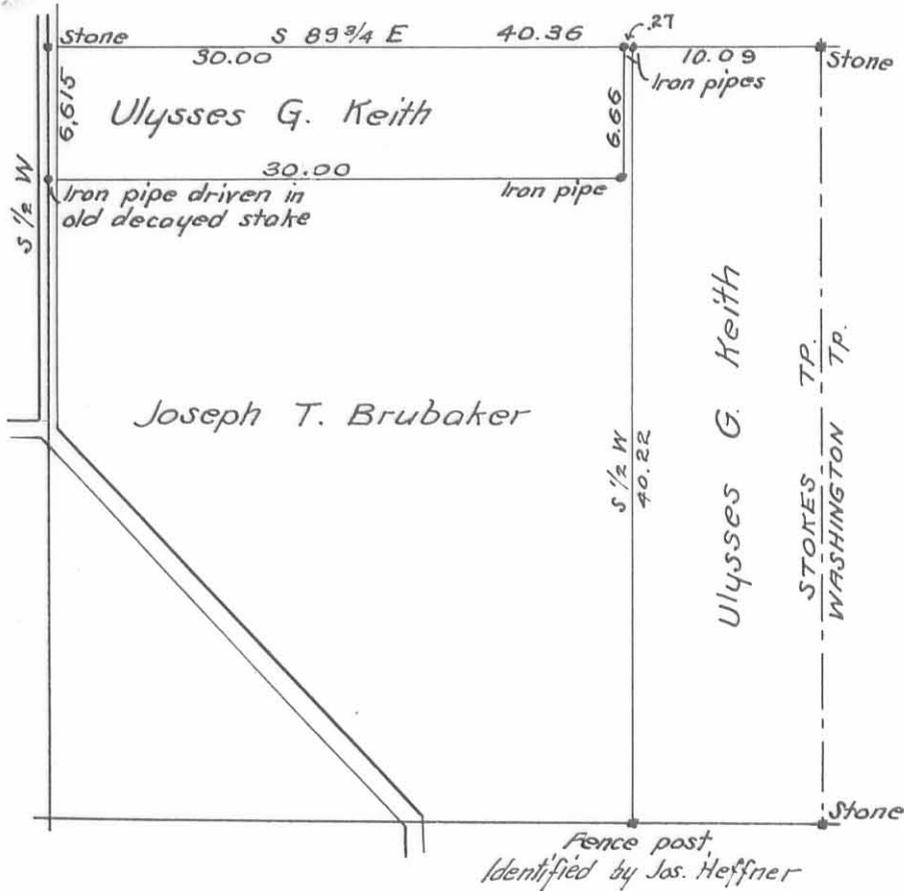

Pt. Sec. 2. T. 7. R. 8

Stokes Tp. Logan Co. Ohio.

A. R. Youngbeters }
E. C. Neesecker } ch. crs. Sworn.

Deposition Taken by County Surveyor.

In the matter of the Application of U. G. Keith for survey of a certain tract of land.

Deposition of Joseph F. Heffner taken before me, Deputy County Surveyor of Logan County, Ohio, in the above case at the line between the lands of U. G. Keith and Jos. Brubaker, on the 27 day of Sept. 1911.

Said Joseph F. Heffner of lawful age, being by me first duly sworn, as herein-after certified, deposes and says as follows:

1st Ques. - State your name, age, occupation and place of residence

Answer: - My name is Joseph F. Heffner. I am 68 years of age, I am "retired" by occupation, my place of residence is Bellefontaine, Ohio.

2^d Ques. - Did you formerly own the 40 acre tract on the east side of the SW quarter of Sec. 2. T. 7. R. 8?

Ans. - Yes.

Q: - Was the dividing line between this tract and Mr. Brubaker's tract ever located by a surveyor

Ans. - It was, by Mr. McCormick.

Q: - When was the survey made?

Ans. - I think within about a year from the time I bought the place.

Q: - Can you locate or identify any corner or points in this line? If so, designate, or point them out.

Ans. - (Pointing to corner post just north of gate) This post is where the stake was set by the surveyor

Q: - What information can you give about the present wire fence north from this post?

Ans. - This fence was set in line of old rail fence by Mr. Pribble, or at least this end of the fence, and I believe is as near on the line as could be placed.

Signed by J. F. Heffner

- Certificate to Deposition -

State of Ohio Logan Co. ss.

I, Harry S. Dailey, Deputy County Surveyor of Logan County, Ohio, do hereby certify, that the above named Joseph Heffner was by me first duly sworn to testify the truth, the whole truth, and nothing but the truth, and that the deposition by him subscribed as above set forth was reduced to writing by me and also so written in the presence of the witness aforementioned, and was subscribed by said witness in my presence, and was taken at the time and place specified in the caption hereof.

In Witness Whereof, I have hereunto set my hand, and affixed my seal of office this 27 day of September A.D. 1911

Harry S. Dailey
Deputy County Surveyor