


294

INDEXED ON MAP

slough Road.

center of bridge at slough ditch.

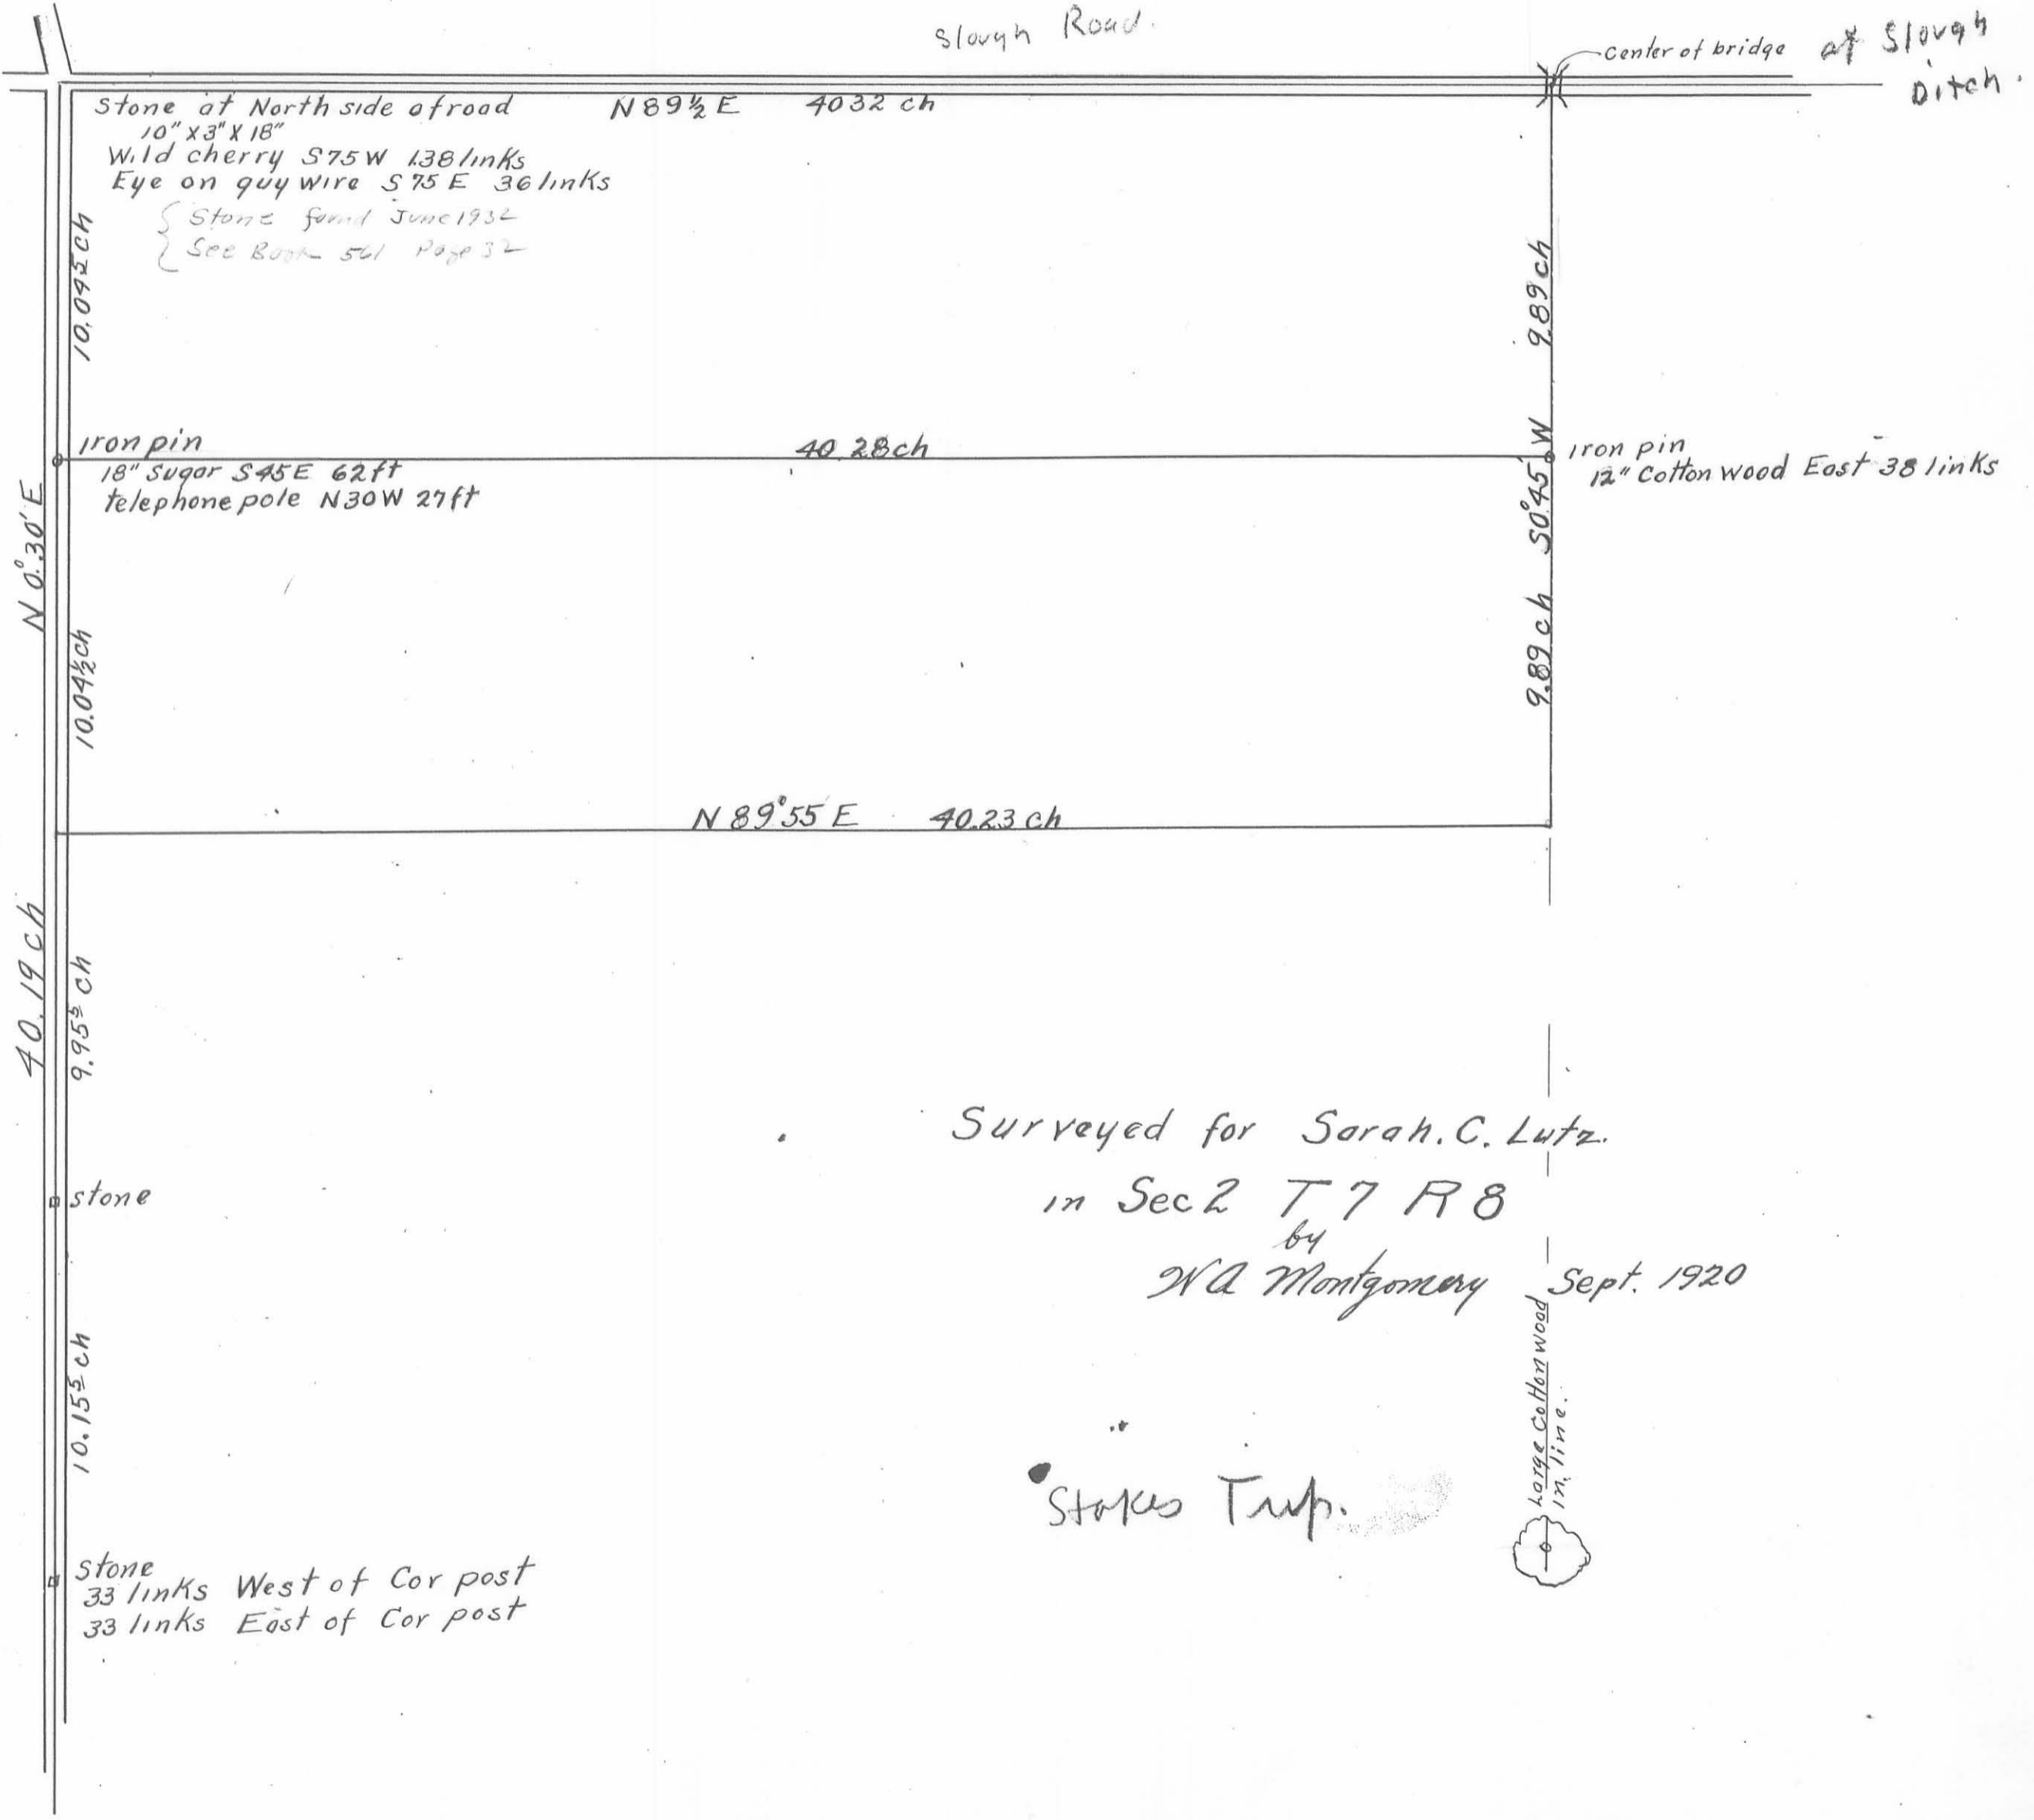

Surveyed for Sarah C. Lutz.
 in Sec 2 T 7 R 8
 by
 W A Montgomery Sept. 1920

Stakes Trip.

