

Orra Van Horn Sep 15

Found stone SE Cor Sect
 Measured West 20.15 ch. N 89° E
 found stone

Measured North 96.9 ch rd
 set stake 29.75
 Total 90.32 to Stone
 N 1° E

S 88° E
 20 22 - division line on
 Northside 60.A Tract.

Measured North 856 Stone Corn
 7.88 N " "

S 2° W

33.91 fence NW
 30.74 Stone
 40.40 fence East
 50.92 fence West

→ 2.66 N of fence

243
 INDEXED ON MAP

T6 R8

2014

March 9th 1922

40.32

29.75

10.58

2022

250.37

20.195

29.75

100.95

141.33

181.71

90.32

60.275

N 86 3/4 W

20.17

.013

.6057

2017.07000

10.03

6057

243.2

Stone

20.24

20.23

4100

19.7

Stone

Stone

Long 60.4 Miles

S 88° E N 86 3/4 W

20.22

Stone

Stone

12° 18' W

40.32

29.74

120° E

30.69

Stone

20.15

N 88 3/4 W

Stone

20.04

100.07

S 2° W

20.04

Stone

Stone


Stone

Stone

Stone

Stone

43A

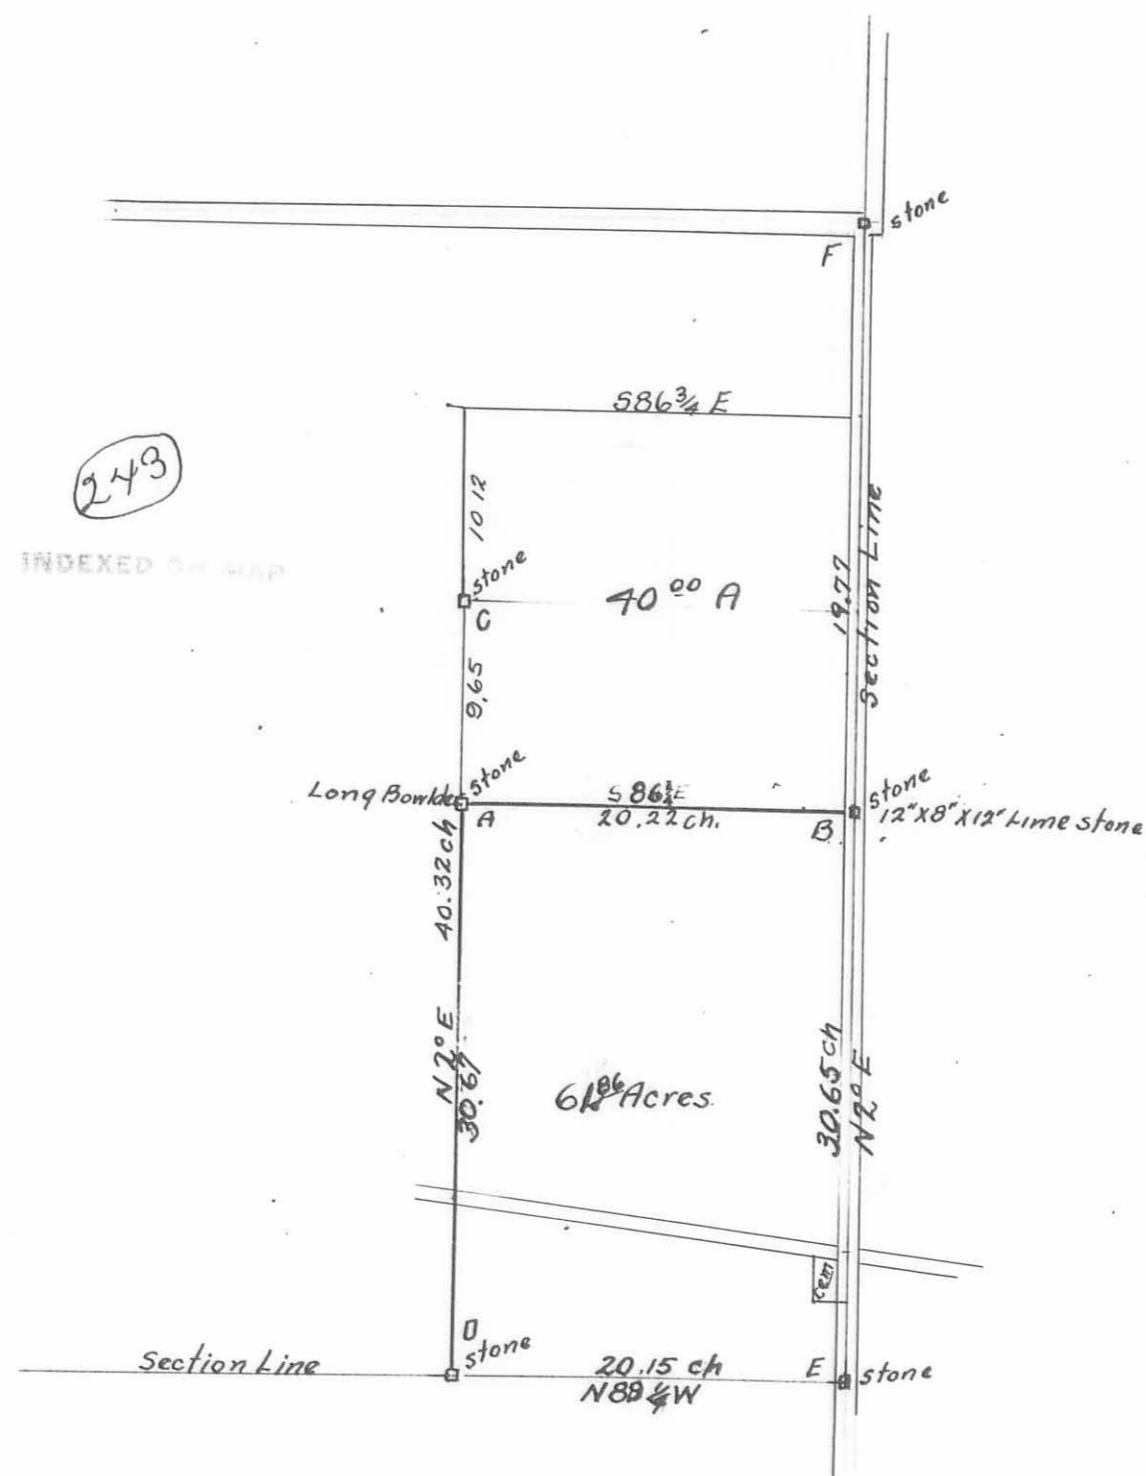

Part of Sec 15 T6 R8

STOKES TOWNSHIP

for Orra Vanhorn

by W.A. Montgomery Deputy County Surveyor

March 9 1922

A = Long Boulder placed on line with C & D

B = 12"x8"x12" lime stone placed on line with E and F

E = Section Corner See Surveyors Record Vol. C, page 314

Field Notes Book 502 Page 75