


Anglaize Co.,
Sec. 24 T6. R7.

- 851.517 80.325 q. South line Sec. since west
- " 87.065 point and road on Sec. line east
- " 120.425 fence west quarter Sec. line Idlle ^{and} Neal
- " 126.28 point S of out over q. line east
- " 16

534

Sec. 24 T6. R7.

March 16th 85 Transit line

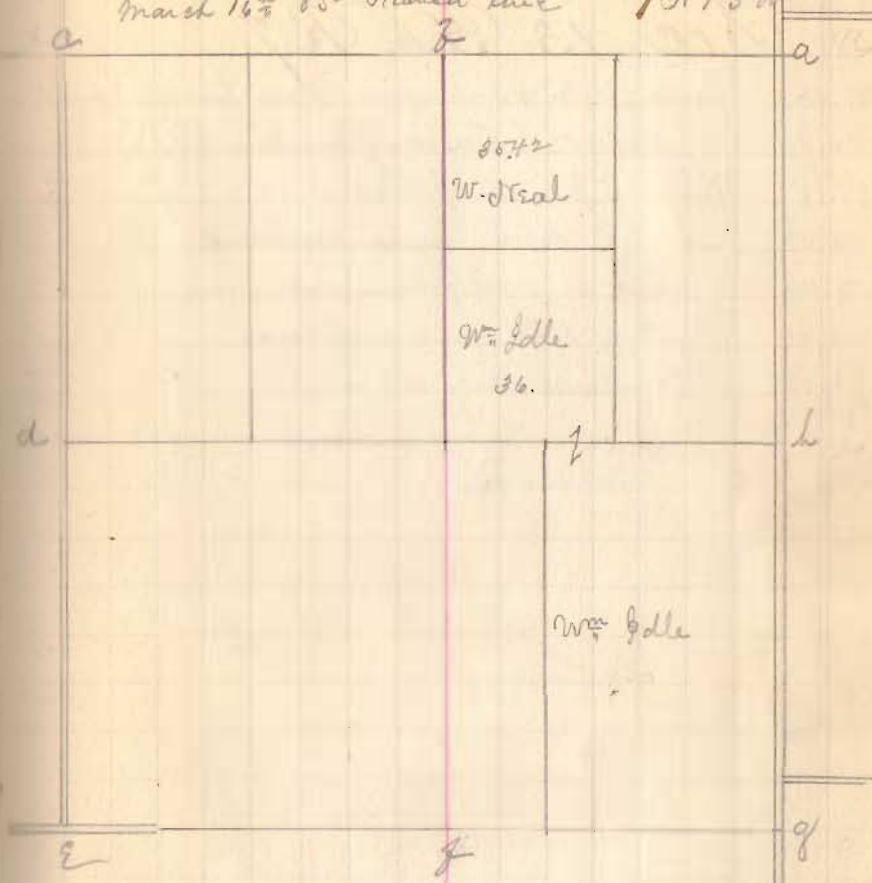

534

INDEXED ON MAP