


Note
 E to F not measured
 line hit 3" East of Mon #41 at F

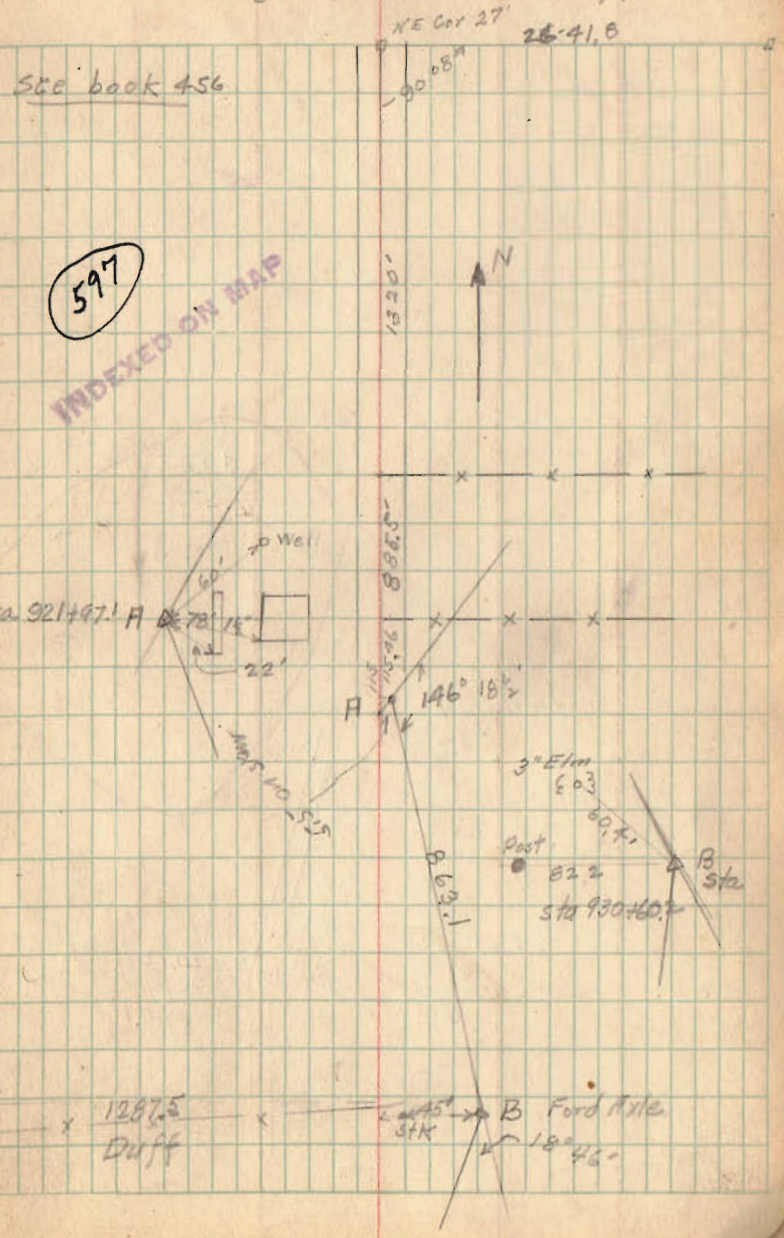

See book 456

597

INDEXED ON MAP

1287.5
 Duff
 B Ford Ave
 18°46'