


Road 88

Sta 0 TO 86+10

70

Road # 224 Stokes

Sta. 86+10 to 121+69

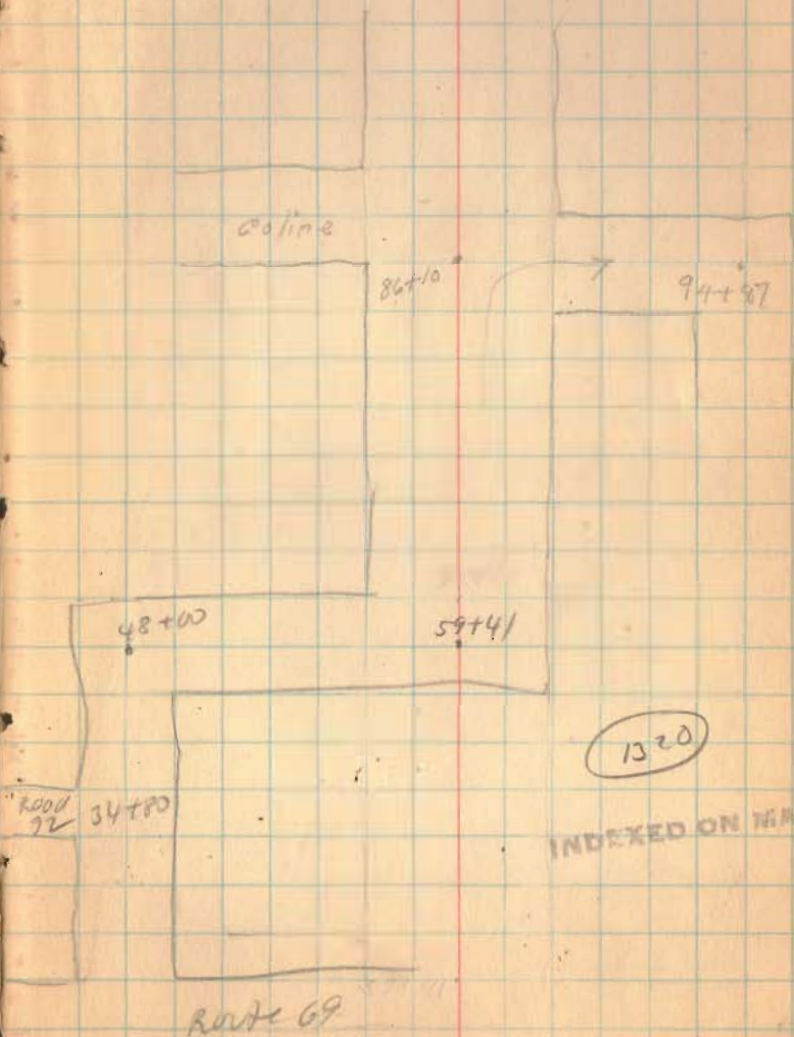

1100 W. 10th St.

121+69

99+13

S

94+97