

Road 89 stakes Twp.


No record found.
Stakes Placed 15' from $\frac{1}{2}$ for a
30' road

1358
INDEXED ON MAP

March-23-1932


Wright
McKeehan 6
H.R. Cline

Clear
Ground Frost

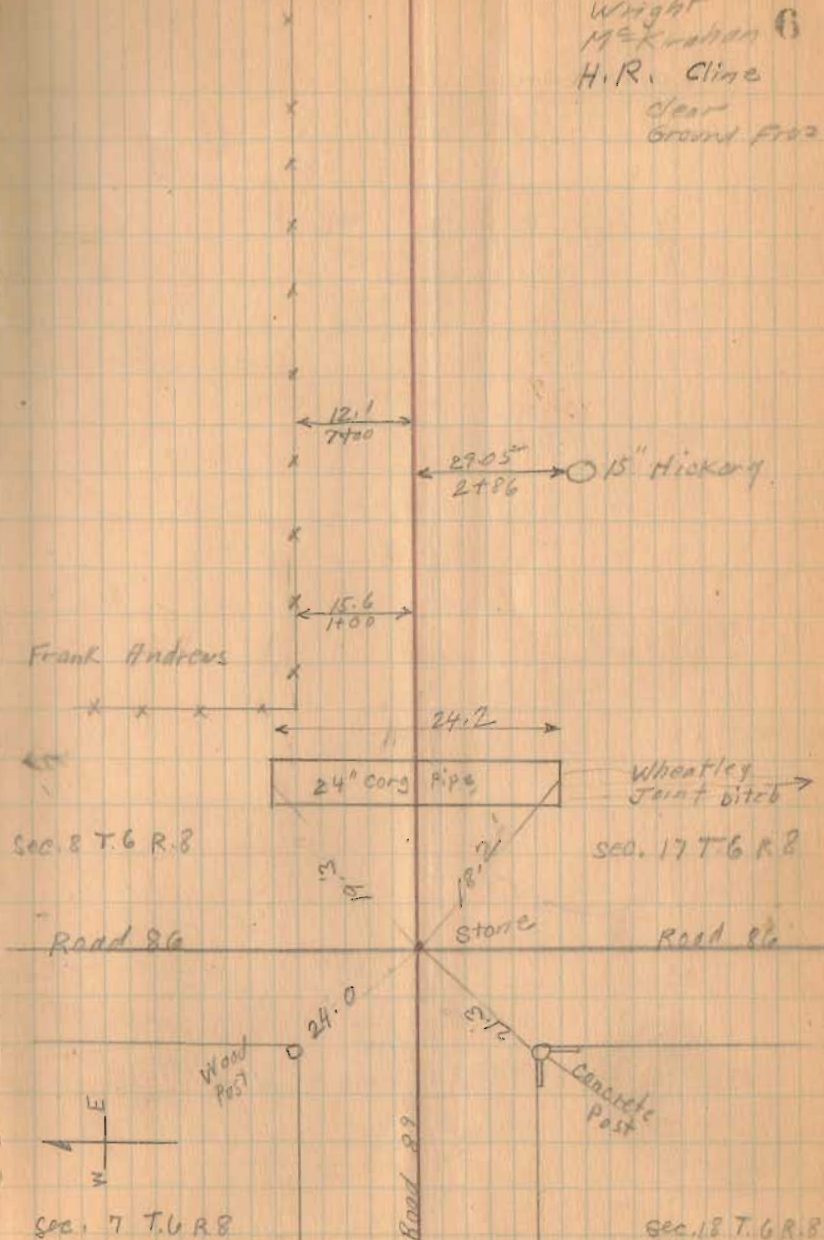

Road 89

1557
INDEXED ON MAP

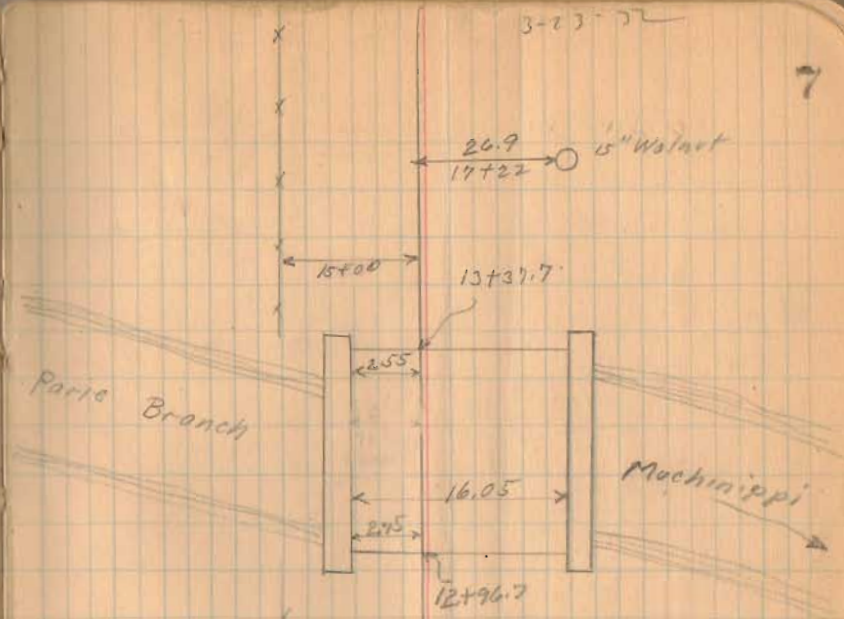

Road 89

1557
INDEXED ON MAP

3-23-32

10

