

Lots 38 & 39 Tecumseh Island  
Indian Lake Stokes Trap.


Haldy Survey

- A. Old Hub Found
- B.  $\frac{3}{4}$ " Iron
- C.  $\frac{1}{2}$ " Iron Pipe
- D. Iron Found
- E. Old Hub Found
- F. Hub
- G. Hub
- H. Iron Found
- I.  $\frac{1}{2}$ " Iron
- J. Iron Found
- K. Hub
- L. Old Hub Found
- M. Old Hub Found
- N.  $\frac{1}{2}$ " Iron Pipe
- O.  $\frac{3}{4}$ " Iron
- P.  $\frac{3}{4}$ " Iron
- Q. Hub
- R. Hub
- S. Hub

1604


INDEXED ON MAP

Aug. 18, 1934  
F. F. Wright  
Ed. Core

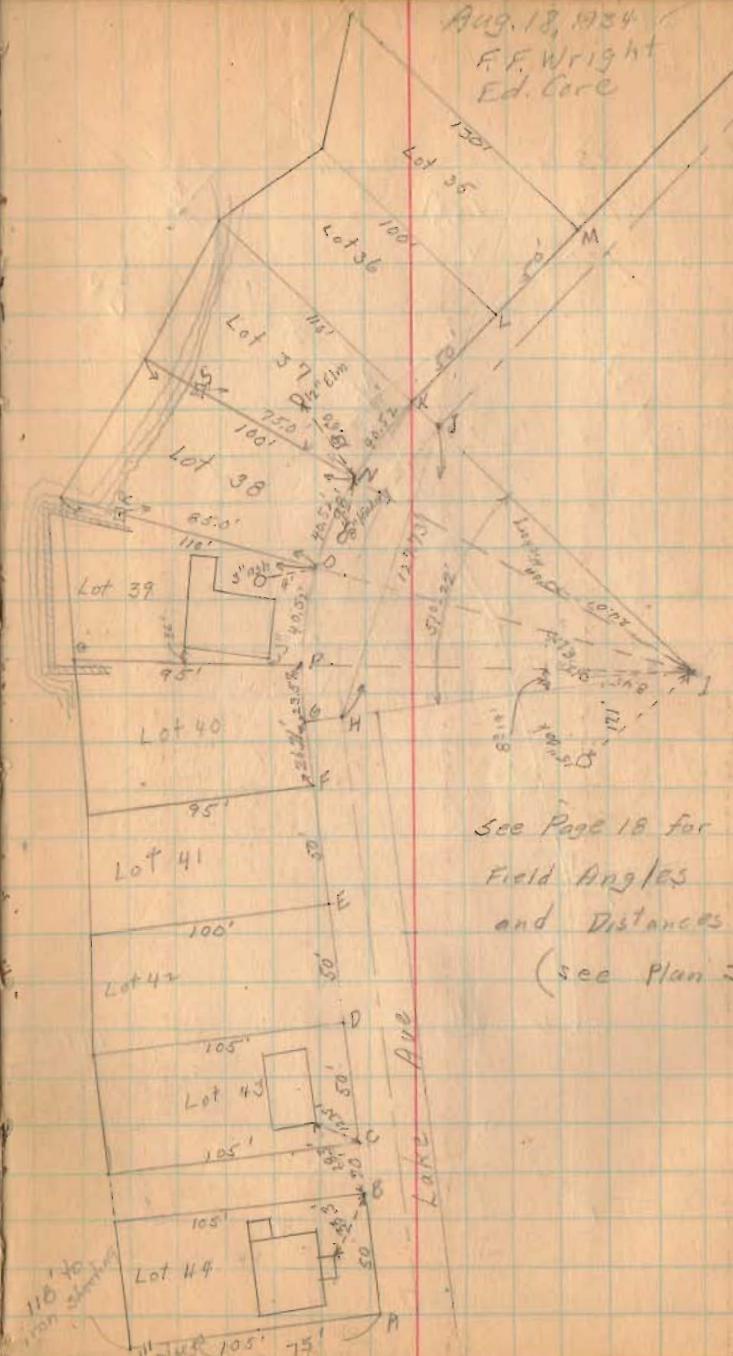

Lots 38 & 39  
Indian Lake

Tecumseh Is 1<sup>nd</sup>  
Stokes Twp.

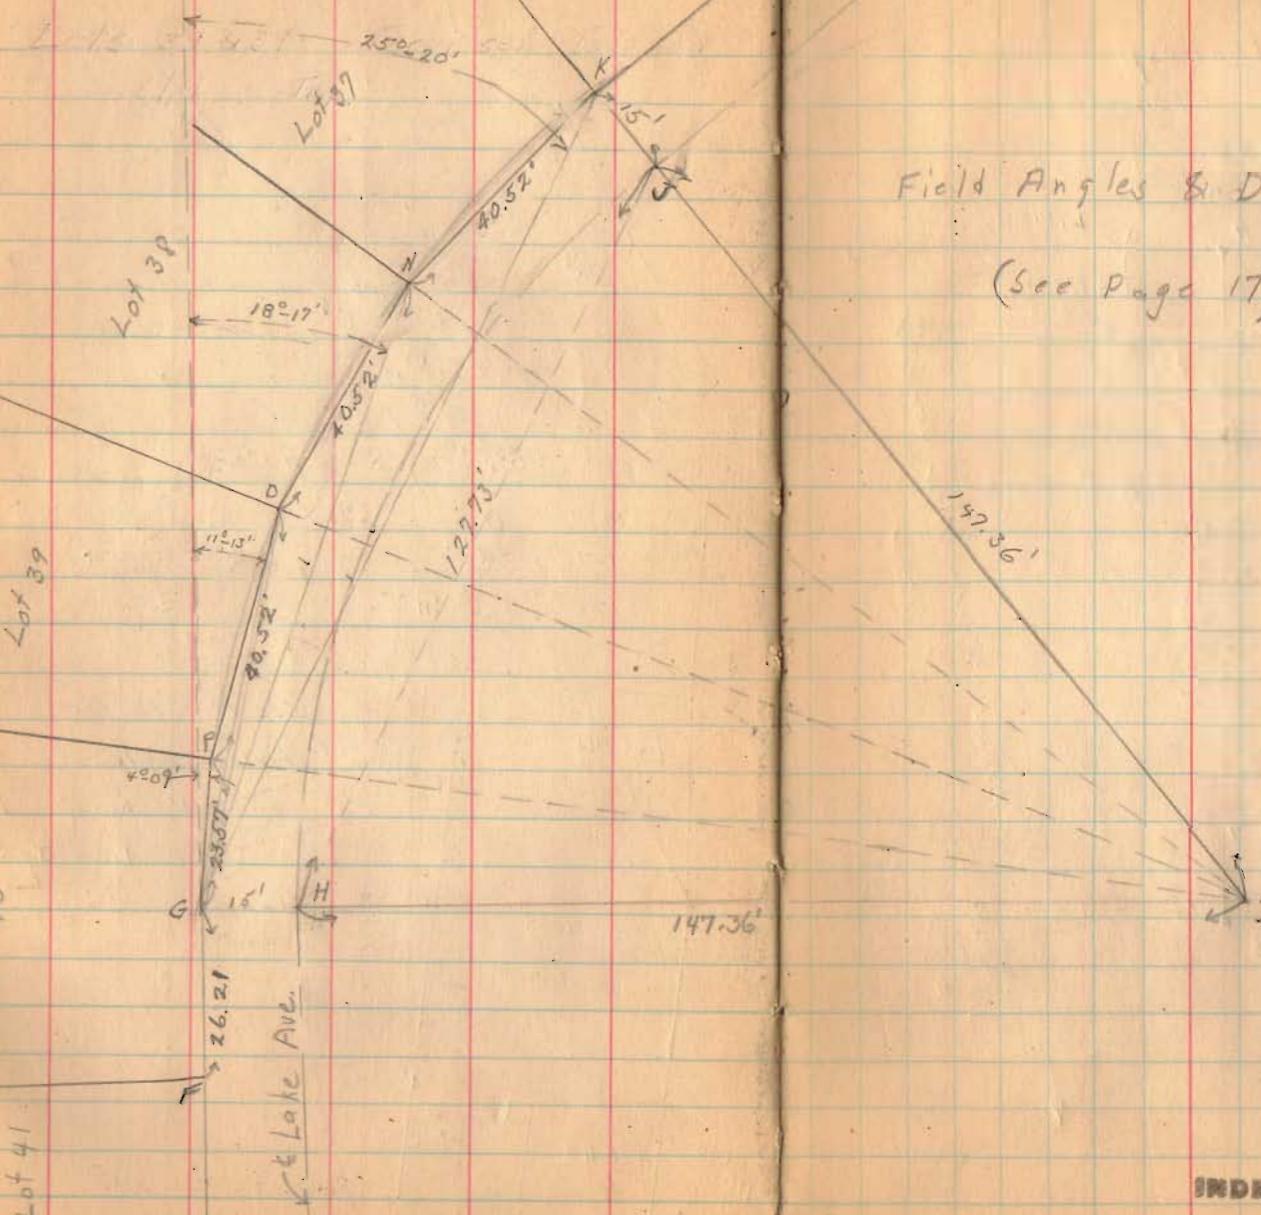

Aug. 18, 1934 18  
F.F. Wright  
Ed. Core

Field Angles & Distances

(See Page 17)

1004

INDEXED ON MAP