


FB 689

Lakeview School Tract Survey

See Plat in Drawer-R  
Index No. 1064

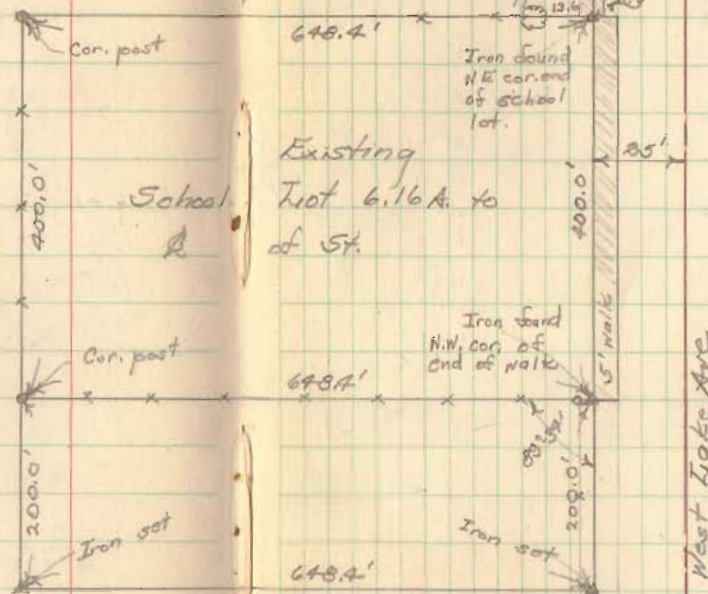

Apr. 30, 1952  
Party: C. Kasper  
G. Williams  
D. Dodson

62

See FB 493, pg 15  
for survey of  
existing school lot

2059

INDEXED ON MAP

Tateview School (contd)

FB 689

Apr. 30, 1952

Party: C. Keyson?  
G. Wilgus?  
D. Dodson

63

