


Survey of Lots 582 and 603
Chippewa Park No. 1
Logan County, Ohio

Lot 582 McIntyre
Lot 603 Cox

July 15, 1946

J.H. Inskip
C.A. Miller 69
J.C. Wheeler

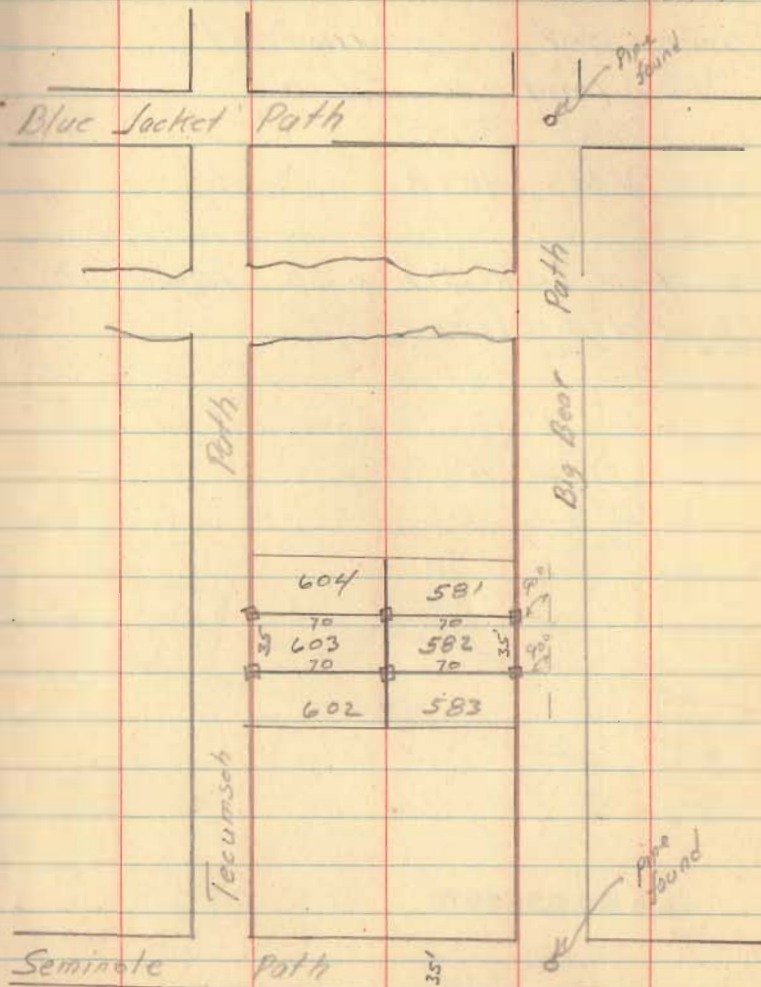

2337

INDEXED ON MAP