

NOTE ~  
 Roof Encroachment  
 @ N.W. cor. = 0.40'  
 @ N.E. cor. = 0.30'

Distance from Res.  
 foundation to lot line  
 @ N.W. cor. = 1.10'  
 @ N.E. cor. = 1.23'

INDEXED ON MAP

SURVEY OF  
**LOT No. 4**  
**O'DELL'S ALLOT.**

STOKES TWP. LOGAN CO., O.


SCALE 1" = 20'

INDEXED ON MAP

2502-1P

Surveyed June 27, 1959  
 By Dan L. Dodson  
 Reg. Surveyor #4270

Lot # 4  
O'DELLS

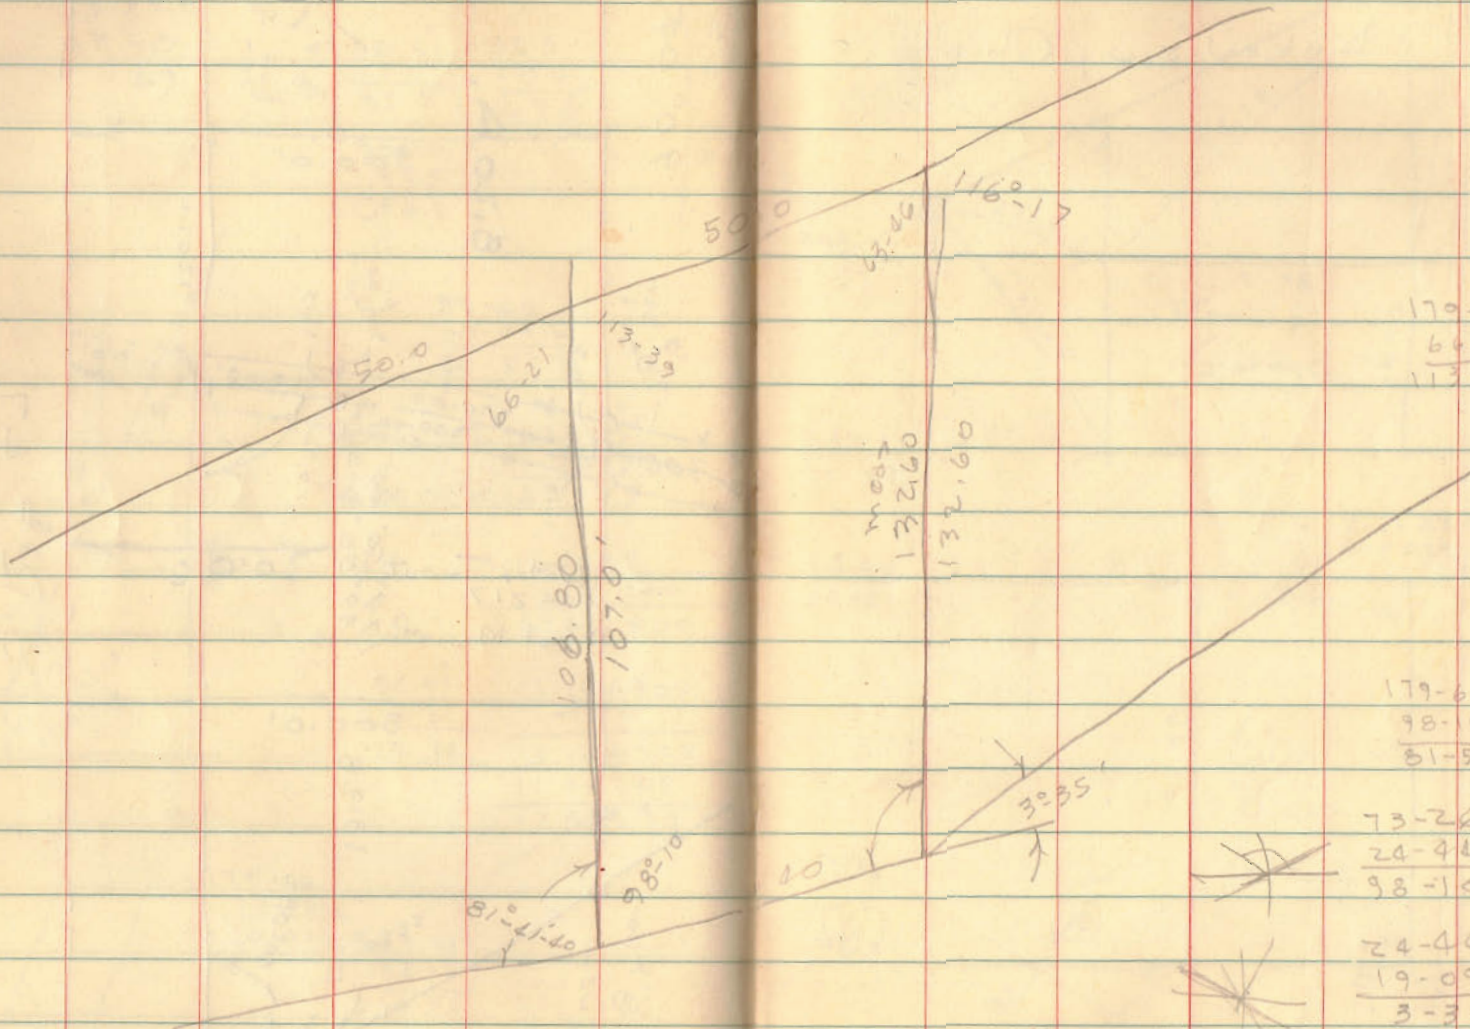

179-60
63-46
116-14

179-60
66-21
113-39

179-60
98-10
81-50

73-26
24-44
98-10

24-44
19-09
3-35



70-51	73-26
7-09	7-09
63-46	66-21

INDEXED ON MAP  
2502