


FB 702

C. H. 286 @
CRANE TOWN ISL.

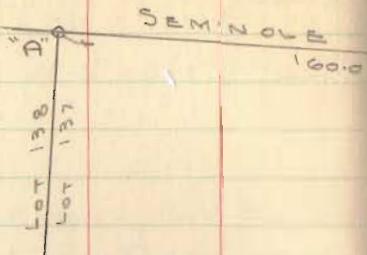

- A = $\frac{3}{4}$ " bolt found (See F.B. 512 pg. 47)
B = $\frac{1}{2}$ Pipe Found @ N.W. cor. lot 133
C = P-K nail set @ intsec. N.line Seminole Dr. &
E C.H. 286
D = 1" Pipe Found @ P.T.
E = tkd. Hub Found @ E P.I.
F = R.R. spk Found @ P.C.
G = $\frac{1}{2}$ pipe Found @ N. line LOGAN DR.
H = " " " S. " "
I = R.R. spk Found @ P.T.


3468

INDEXED ON MAP


D. Dodson
D. Tevis

11/2/61
70°

42

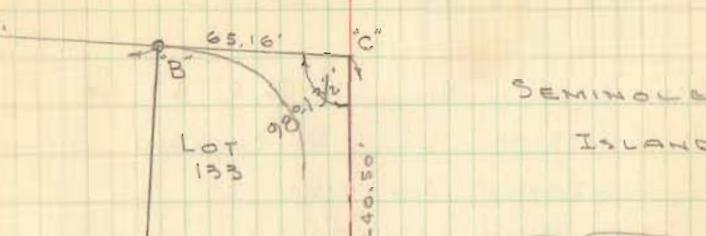

SEMINOLE
ISLAND

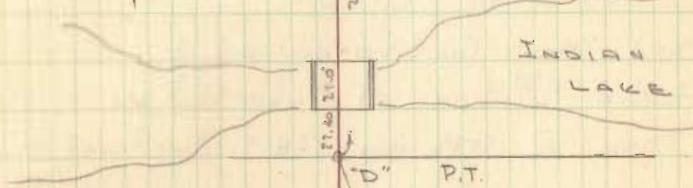

INDIAN
LAKE

$\Delta = 42^{\circ} - 37 \frac{3}{4}'$
 $T = 79.74'$

