

SURVEY OF
BLACK HAWK PATH
(HIPPEWA No. 1)




Dodson
Town's
Line

3-23-62

45°

46

S. Line 52.697

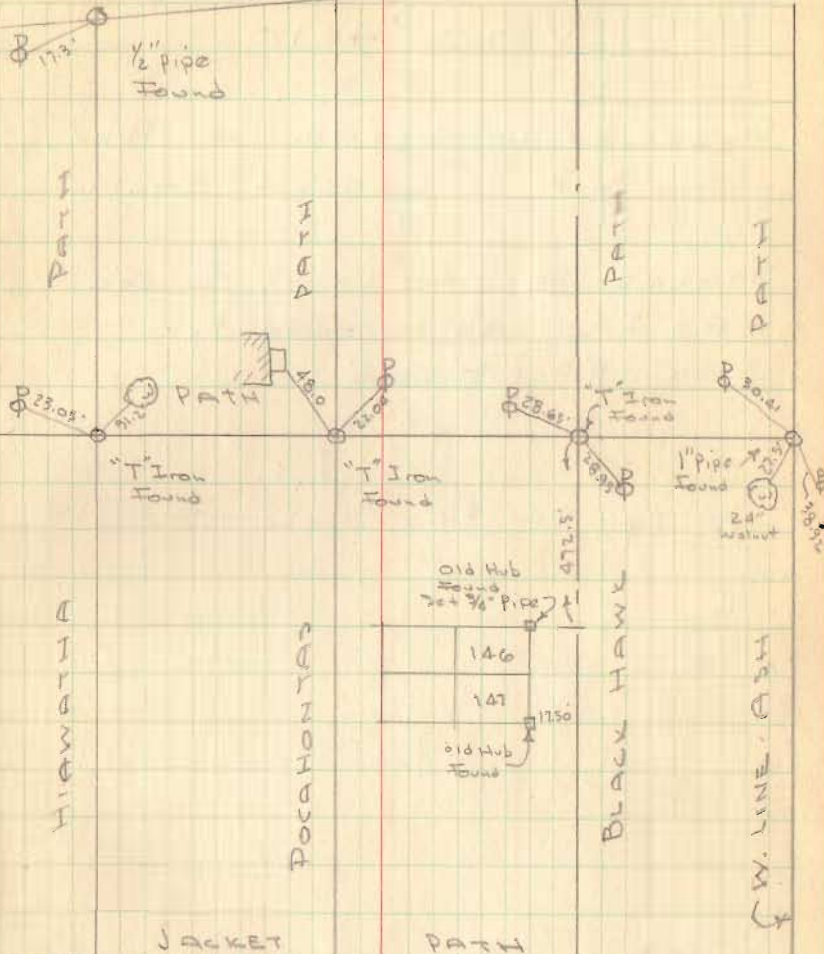

3472

INDEXED ON MAP