Iron Set 7 State Line 8 stron Set

3.75°22'E. 187.61'

Property Line

On Cloyd C. Walters
6.00 Ac.

Steel Post N. 80°35'W. 176.27'

Cloyd C. Walters etal (\$2.50)

WEYANOT SURVEY SEC. 35, T-63, R-80 STOKES TOWNSHIP LOGAN COUNTY, O. JUNE 3, 1964 SCALE I" = 50'

3781)
ENDEXED ON MAR

Don L. Dodson

Bellefontaine, Ohio

REZID 9-29-08 SWM DUC

## Lee Surveying and Mapping Co., Inc.

Land Surveys . Topography . Subdivisions . Construction Layout

117 N. Madriver St. Bellefontaine OH 43311



Phone: (937) 593-7335 Fax: (937) 593-7444

## BRUNSON 0.861 ACRE

Lying in Section 35, Town 6, Range 8, Stokes Township, Logan County, Ohio.

Being all of the James L. Brunson 1.00 acre tract as deeded and described in Official Record 928, Page 895 of the Logan County Records of Deeds and being more particularly described as follows:

Beginning on a 5/8 inch iron rod found on the State line at the northwest corner of the Todd J. Jordan 5.539 acre tract (O.R. 743, Pg. 763) and on the center-line of a 24 feet wide ingress/egress easement.

THENCE, with the west line of the said 5.539 acre tract and the center-line of the 24 feet wide ingress/egress easement, S 08°-12'-00"W, a distance of 185.20 feet to a 3/4 inch iron pipe found.

THENCE, with the north line of the Community Storage and Properties, Ltd., 6.67 acre tract (O.R. 527, Pg. 993, Tract I), N 80°-35'-00"W. a distance of 188.27 feet to a 2 inch steel post found in concrete, passing a 3/4 inch iron pipe found at 12.00 feet.

THENCE, with the east line of the Roger Lusk 0.998 acre tract (O.R. 455, Pg. 45, Tract Two, Parcel One), N 05°-20'-00"E, a distance of 203.83 feet to a 1/2 inch iron pipe found on the State Line.

THENCE, with the State Line, S 75°-22'-00"E, a distance of 199.69 feet to the point of beginning, passing a 5/8 inch iron rod found at 187.61 feet.

Containing 0.861 acre.

(0)

B SIONAL SUP B SSIONAL SURVINION OF TAMP IN C

ORIGINAL STAMP IN GREEN

The basis for bearings is the State Line, being S 75°-22'-00"E. This is not a boundary survey pursuant to Chapter 4733-37 of the Ohio Administrative Code. This description was prepared from survey records.

Property is subject to a 12.00 feet wide easement west of and parallel to the east property line. The sidelines of said easement to be shortened or prolonged to meet at angle point intersections.


Description prepared by:

William K. Bruce Professional Surveyor 7437 September 26, 2008

4706098



REUD 9-29-08 SM OU (BASIS FOR BEARINGS) S 75°22'00" E ROGER LUSK 0.998 ACRE - 12' EASEMENT FOR O.R. 455, PG. 45 0.861 ACRE TRACT TWO, PARCEL ONE INGRESS/EGRESS JAMES L. BRUNSON 1.00 ACRE O.R. 928, PG. 895 12' EASEMENT FOR — INGRESS/EGRESS TODD J. JORDAN 5.539 ACRES N 80°35'00" W O.R. 743, PG. 763 **REFERENCES:** COMMUNITY STORAGE AND PROPERTIES, LTD. 6.67 ACRES O.R. 527, PG. 993 1. PLAT OF SURVEY ENTITLED "WEYANDOT SURVEY" TRACT I BY DAN L. DODSON, PS 4270, DATED JUNE 3, 1964 2. PLAT OF SURVEY ENTITLED "MAXINE GILLETTE RESURVEY" BY DANIEL E. GILBERT PS 5402, DATED 2-7-1996.

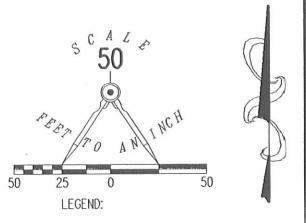

- → 3/4 INCH IRON PIPE FOUND
- Ø 2" STEEL POST FOUND IN CONCRETE
- 1/2 INCH IRON PIPE FOUND
- 5/8 INCH IRON ROD FOUND

MAP PREPARED OF THE JAMES L. BRUNSON 1.00 ACRE TRACT OFFICIAL RECORD 928, PAGE 895 SECTION 35, TOWN 6, RANGE 8 STOKES TOWNSHIP LOGAN COUNTY, OHIO

> THIS IS NOT A BOUNDARY SURVEY PURSUANT TO CHAPTER 4733-37 OF THE OHIO ADMINISTRATIVE CODE. THIS MAP WAS PREPARED FROM RECORD. SEE REFERENCES.

MAP PREPARED BY:

WILLIAM K. BRUCE PROFESSIONAL SURVEYOR 7437 SEPTEMBER 26, 2008

COPYRIGHT 2008 BY:

LEE SURVEYING & MAPPING CO., INC. 117 North Madriver Street BELLEFONTAINE, OHIO 43311 (937) 593-7335

surveys@lsminc.us KSS D0908 4706098 L-4706-3

ORIGINAL STAMP IN GREEN


INDEXED ON MAP 3781 2P



2 WORKING DAYS


BEFORE YOU DIG

CALL TOLL FREE 800-362-2764 OHIO UTILITIES PROTECTION SERVICE.

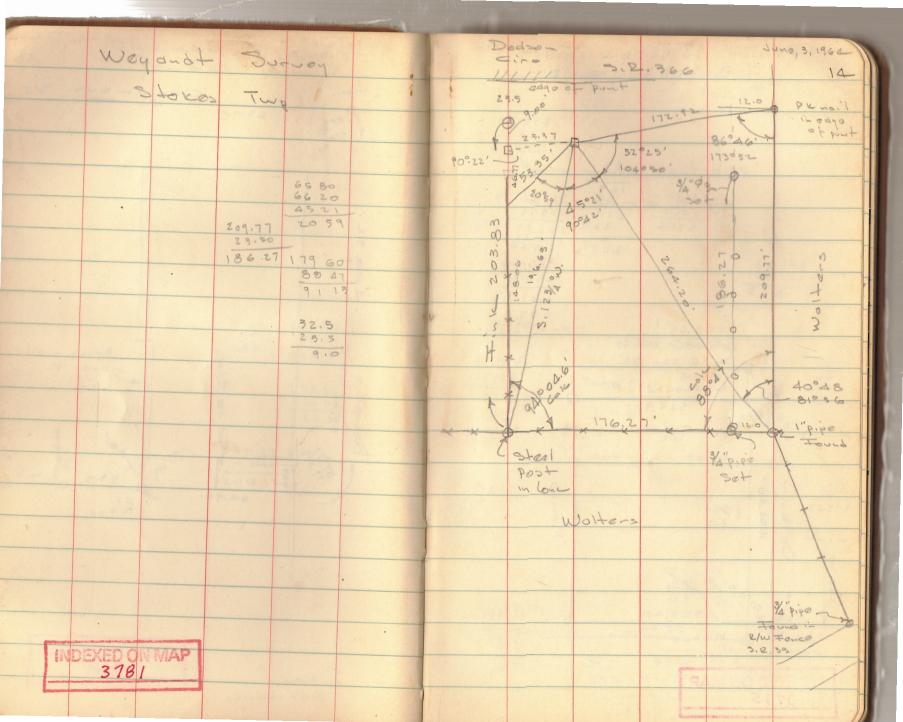

9-14-13

## Lee Surveying and Mapping Co., Inc.

 

117 N. Madriver St. Bellefontaine OH 43311



Phone: (937) 593-7335 Fax: (937) 593-7444 surveys@lsminc.us

## STATE OF OHIO 0.073 ACRE

Lying in Section 35, Town 6, Range 8, Stokes Township, Logan County, Ohio.

Being out of the State of Ohio lands and being more particularly described as follows:

Beginning on a MAG nail found on the State line at the northwest corner of the Todd J. Jordan and Vonda L. Jordan, as Co-Trustees, 5.539 acre tract (O.R. 1101, Pg. 708, Tract 2, Parcel I) and the northeast corner of the William S. Monsma and Judith A. Monsma, Trustees, 0.861 acre tract (O.R. 1007, Pg. 118).

THENCE, with the north line of the said 0.861 acre tract, N  $75^{\circ}$ -22'-00"W, a distance of 199.46 feet to a ½ inch iron pipe found, passing a 1 inch iron rod found at 12.04 feet.

THENCE, with the west line of the said 0.861 acre tract extended, N 05°-26'-43"E, a distance of 16.07 feet to a MAG nail set on the south right-of-way of Ohio Route 366.

THENCE, with the south right-of-way of Ohio Route 366 (78 feet wide, 48 feet south and 30 feet north), S 75°-26'-55"E, a distance of 200.22 feet to a MAG nail set.

THENCE, with the west line of the Todd J. Jordan and Vonda L. Jordan, as Co-Trustees, 0.115 acre tract (O.R. 1101, Pg. 708, Tract 2, Parcel II) S 08°-15'-44"W, a distance of 16.25 feet to the point of beginning.

Containing 0.073 acre.

WILLIAM

K. BRUCE 7437

GISTER

ORIGINAL STAMP IN GREEN

STONAL

Property is subject to any and all previous easements and rights-of-way of record.

The basis for bearings is the State line, being N 75°-22'-00"W, and all other bearings are from angles and distances measured in a field survey by Lee Surveying and Mapping Co., Inc. on July 17, 2013.


Description prepared by:

Walliam K. Bum

William K. Bruce Professional Surveyor 7437

September 11, 2013

50330613A

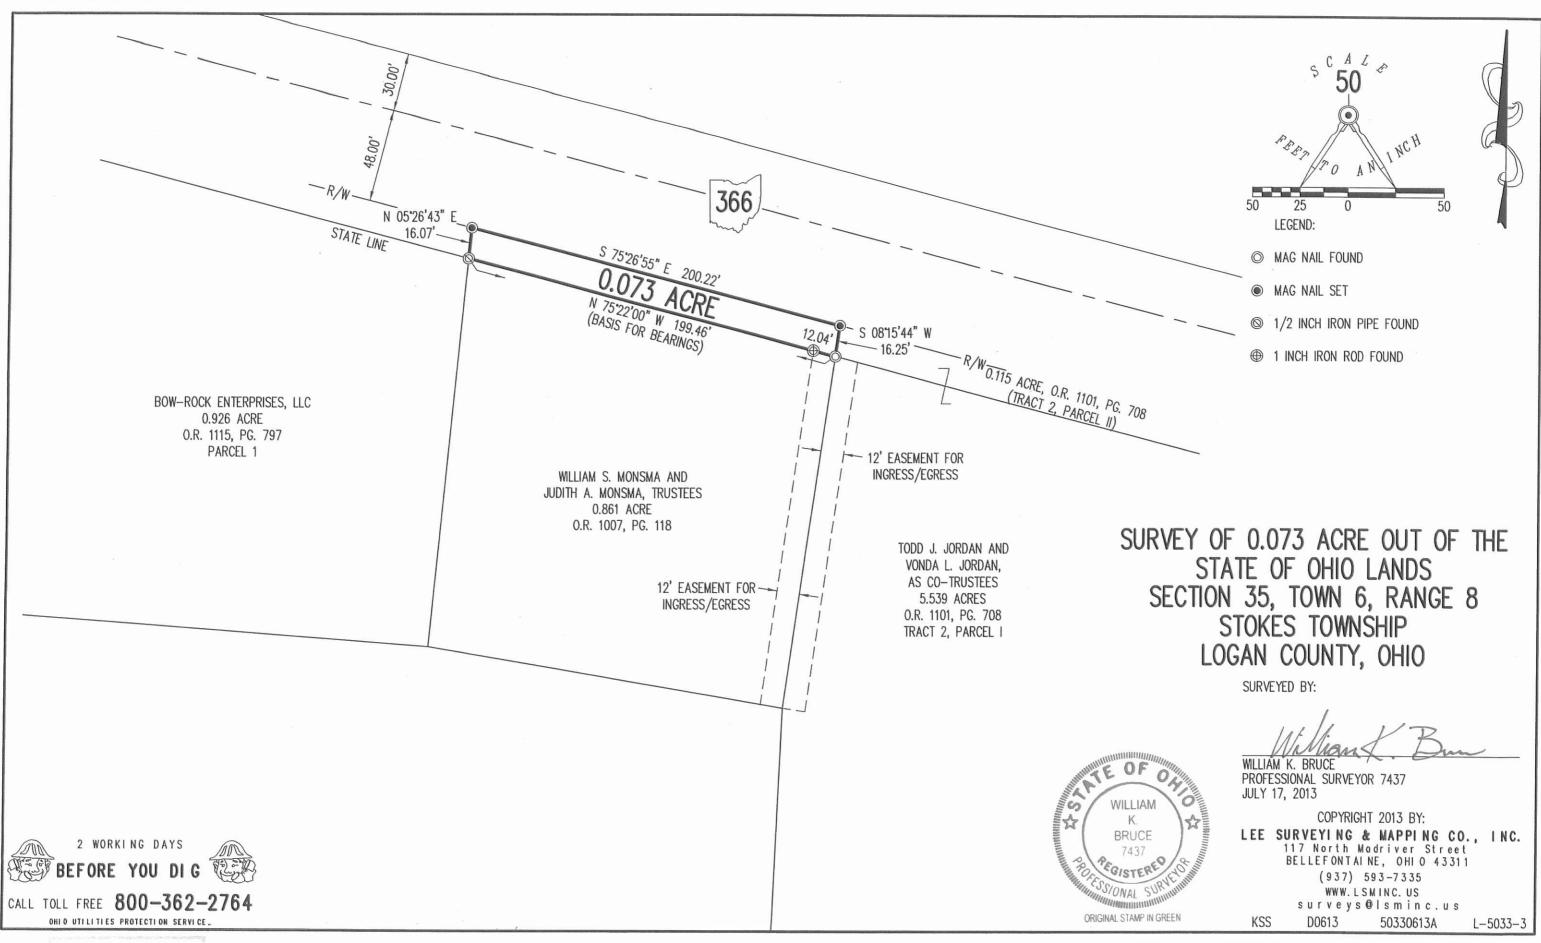

3781 3 P