


ELMWOOD CHANNEL

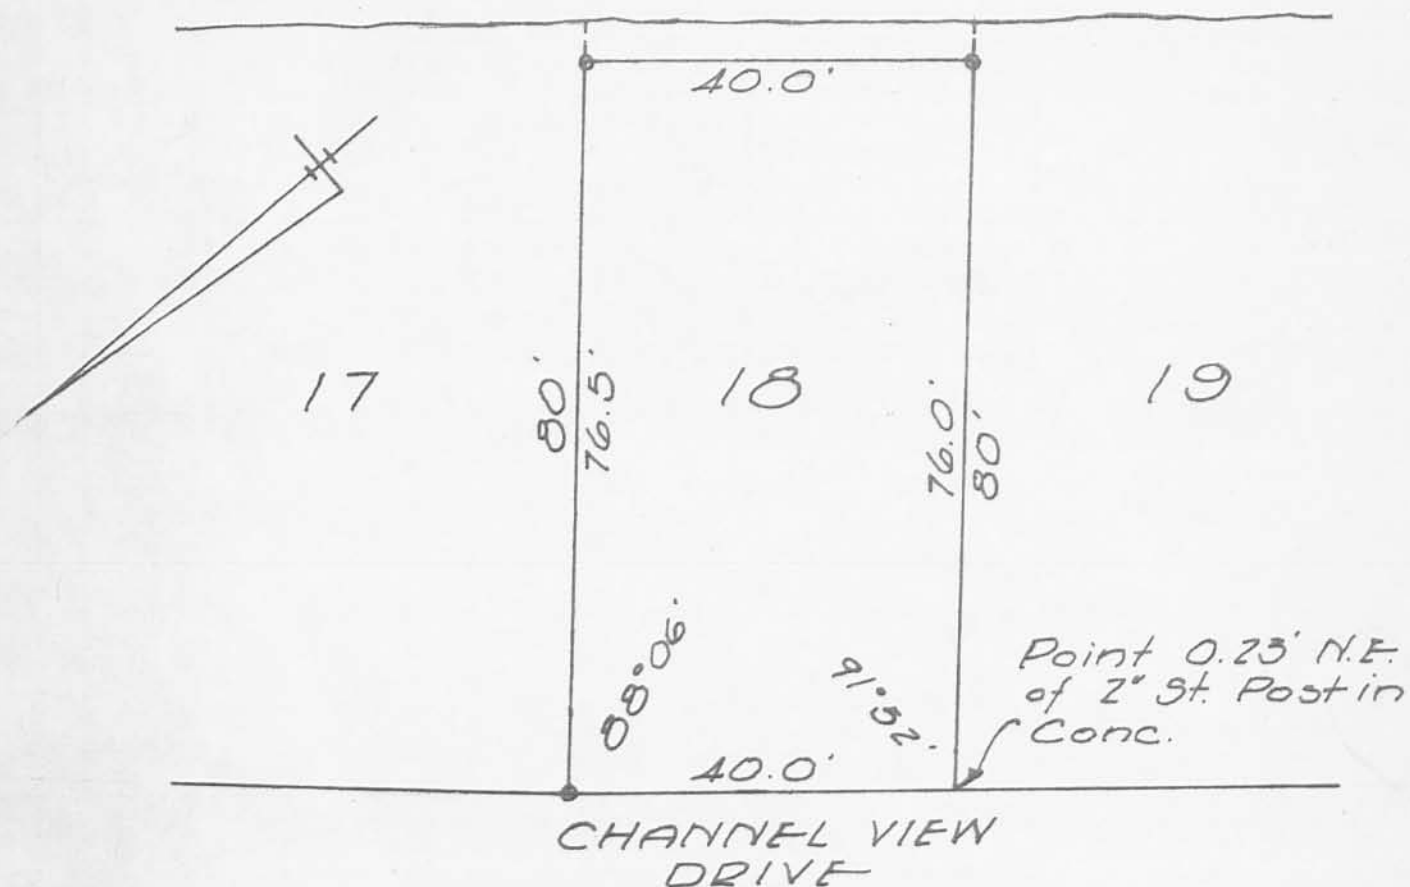

SURVEY OF LOT 18  
 WEST SIDE SUBD. No. 1  
 STOKES TOWNSHIP  
 LOGAN COUNTY, OHIO  
 JAN. 28, 1967  
 SCALE 1" = 20'

INDEXED ON MAP

4260

Dan L. Dodson  
 Dan L. Dodson  
 Reg. Surveyor 4270  
 Bellefontaine, Ohio

o = 5/8" ϕ Rebar set