

FB 700

Survey for State Line  
Lakeview, east to Midway

9+50 = 5+00 on H.S.

Note: States leases  
in red.


According to 1911 survey  
all stations should be  
+58.6 instead of +58.

7+00 = 2+50 on H.S. Ditch

5+58 RR. spite

5+00 = 0+50 on Houchins Slough

32

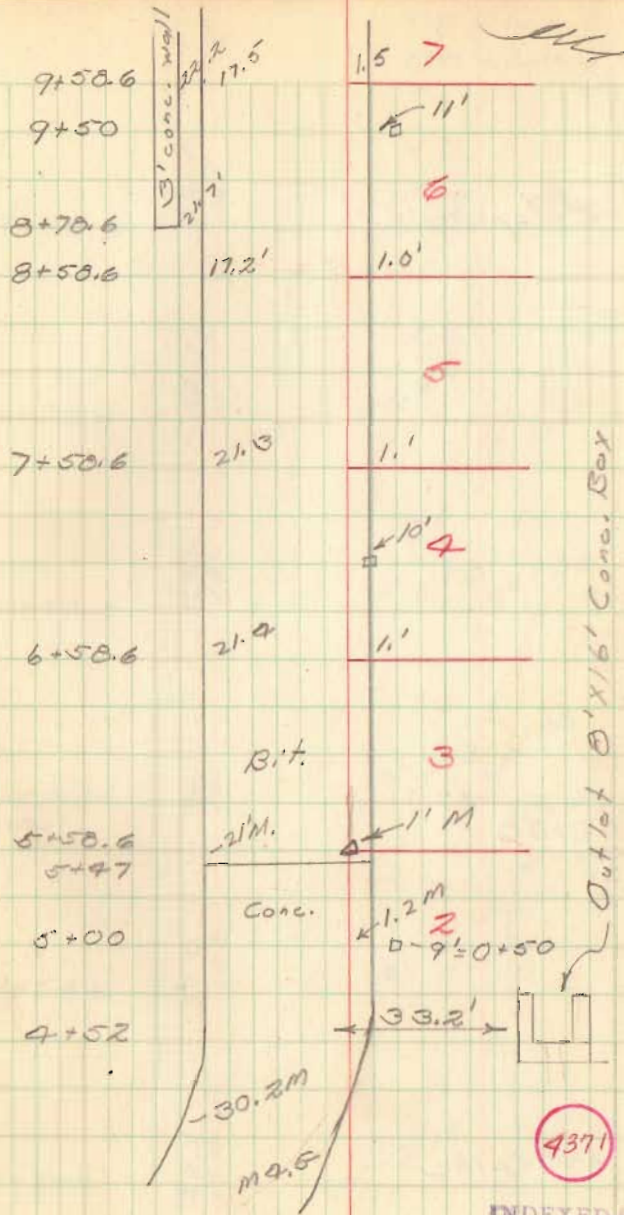

INDEXED ON MAP

FB 700

15+58 RRspike

12+92 = 8+00

10+58 RRspike

15+58.6

14+58.6

13+58.6

12+58.6  
12+92

11+58.6

10+58.6

22.0  
19.1

22.7  
18







21.6  
18'

23.1  
19'

23.0  
17.0

22.2  
17.9 M

TB - top bank  
BB - bottom bank 33

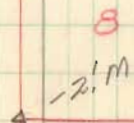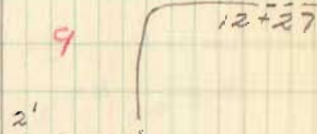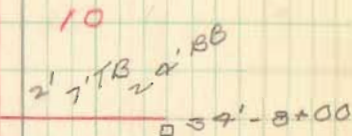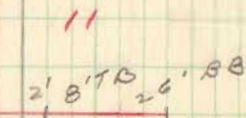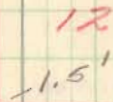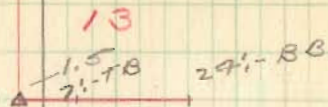


7


12+27



20+58 RR Spike

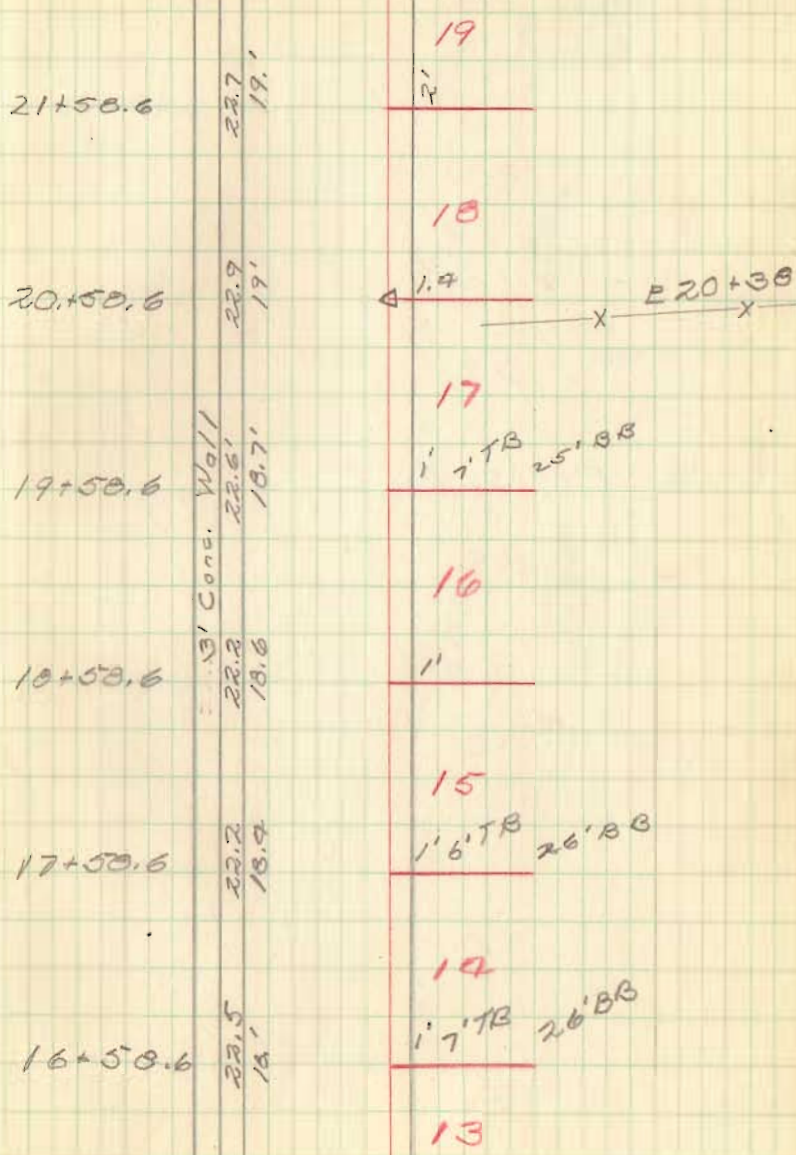

25+58 RR Spike

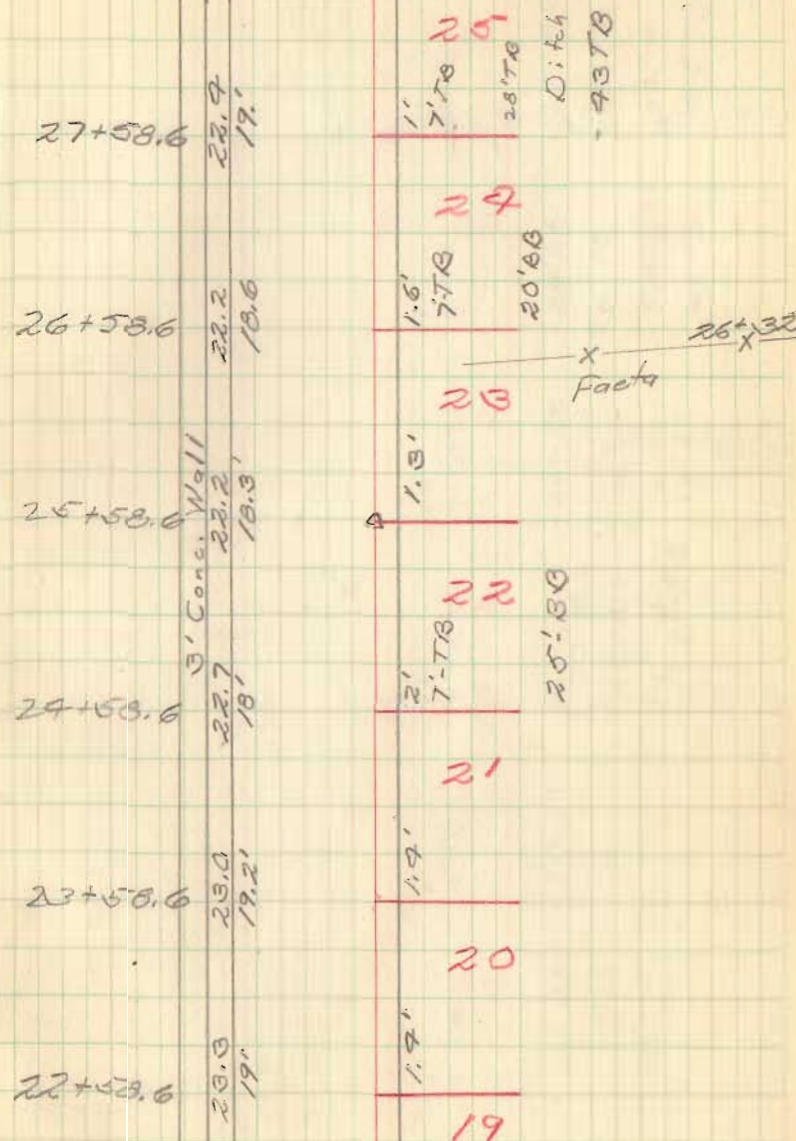

33+58 RR Spike

30+58.6 RR Spike

33+58.6

32+58.6

31+58.6

30+58.6

29+58.6

28+58.6

31' Conc. Wall  
 23.5 19'  
 22.5 19'  
 23.2' 19'  
 21.9 18.6'  
 22.2 19'







39+58.6

23.0  
19.8

0.6'  
6'-78  
- 23'-88

67

40+58.6

26.4  
19.5

0.7'  
6'-78  
- 27'-88

- 39' Edge Pond

41+58.6

23.4  
19.9

0.6'  
6'-78  
- 21'-88

59

- 27' Edge Pond

42+58.6

23.7  
20.

1.1'  
7'-78  
- 26'-88

40

- 35' E Ditch

- 42' TB

42+14 App. E Midway Ave.

66

39+40  
Combs