


STATE ROUTE 235

SCALE: 1"=40'



CHESTER YOUNG, ET UX  
2.00 AC  
D.B. VOL. 389 PG. 383

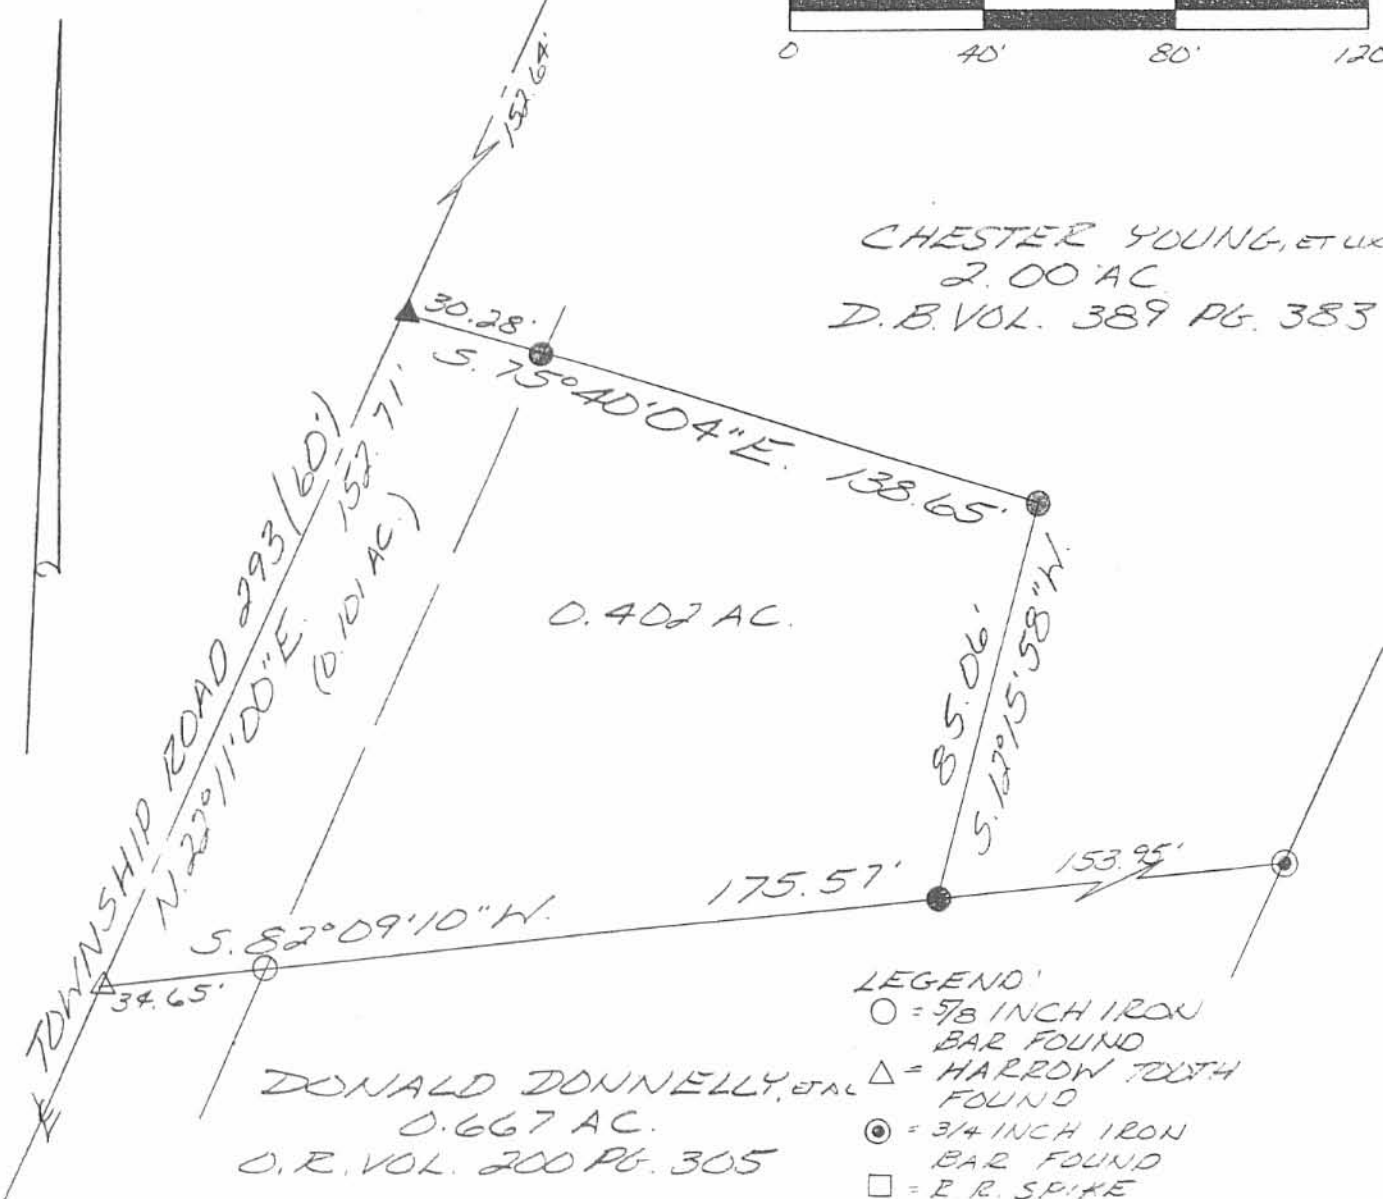

DONALD DONNELLY, ET AL  
0.667 AC.  
O.R. VOL. 200 PG. 305

LEGEND

- = 5/8 INCH IRON BAR FOUND
- △ = HARROW TOOTH FOUND
- ⊙ = 3/4 INCH IRON BAR FOUND
- = P.R. SPIKE FOUND
- = 5/8 INCH IRON BAR SET
- ▲ = MAGNETIC NAIL SET

SURVEY OF 0.402 ACRES IN VIRGINIA MILITARY SURVEY 12277, STOKES TOWNSHIP, LOGAN COUNTY, OHIO FOR CHESTER YOUNG ON DECEMBER 28, 1998



4968 3P

Leslie H. Geeslin  
LESLIE H. GEESLIN  
RUSHSVLVANIA, O  
PH. (937) 468-2793  
FAX (937) 468-7080