






ELM ST. (CONT)

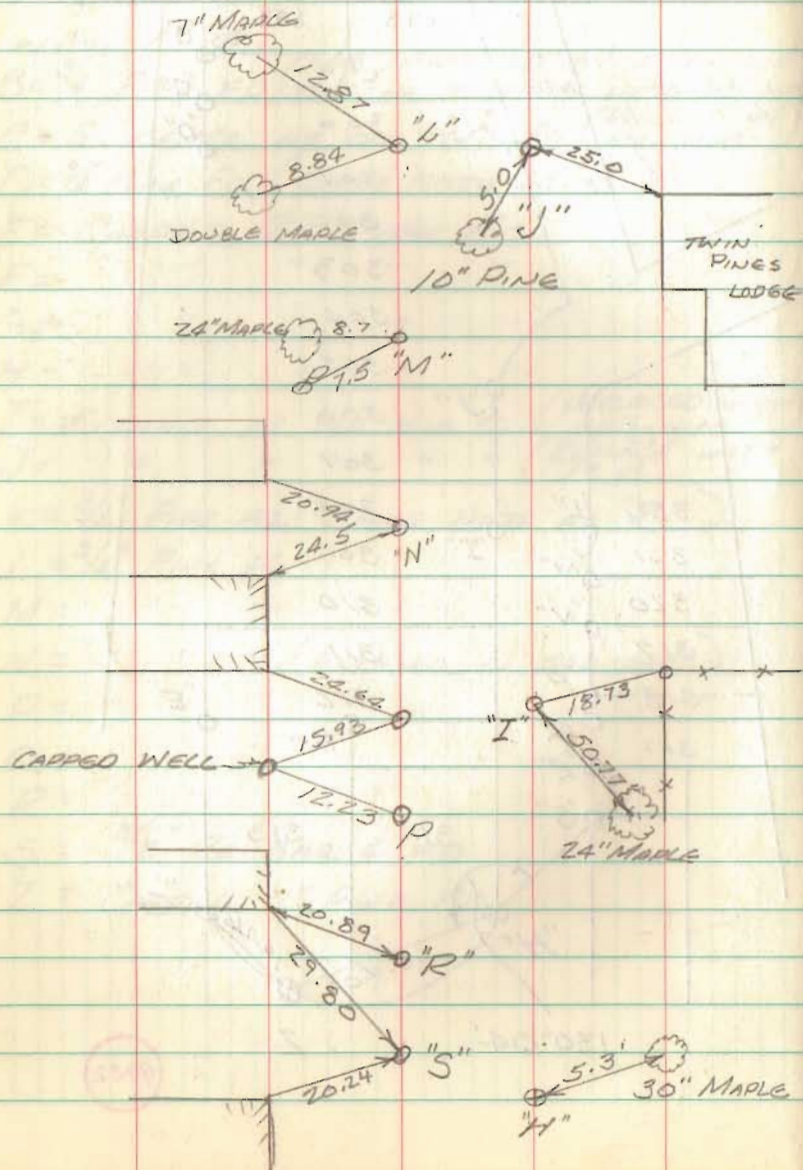

GEESLIN  
NICHOLS  
D. DODSON JR HENRY  
D. BROOKS PRALL

7/16/70

53

