

LESLIE H. GEESLIN  
REGISTERED SURVEYOR NO. 5248  
P. O. BOX 274  
RUSHSVLVANIA, OHIO 43347

PHONE: (513) 468-2793  
NOLTE SURVEY  
August 26, 1975


The following described real estate situated in Stokes Township, Logan County, Ohio and being part of the northwest  $\frac{1}{4}$  of the northwest  $\frac{1}{4}$  of Sec. 17, Town 6 South, Range 8 east and being more particularly described as follows;

Beginning at a stone at the northwest corner of Section 17 at the intersection of Township Roads 86 and 89; thence with the centerline of said T. R. 89 S.  $88^{\circ} 10.2'$  E. 236.0 feet to an iron bar; thence S.  $1^{\circ} 30.1'$  W. 244.95 feet to an iron bar, passing an iron bar at 20.0 feet; thence N.  $88^{\circ} 40'$  W. 236.0 feet to an iron bar in the centerline of T. R. 86, passing an iron bar at 216.0 feet; thence with said T. R. 86 N.  $1^{\circ} 30'$  E. 247.0 feet to the place of beginning.


Containing 1.33 acres more or less.

The above described 1.33 acres being in the northwest corner of Arthur C. Nolte's 20.00 acre tract.

I hereby certify that the above is a true and accurate description of a survey made by me.

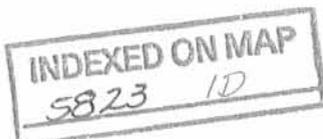

Leslie H. Geeslin

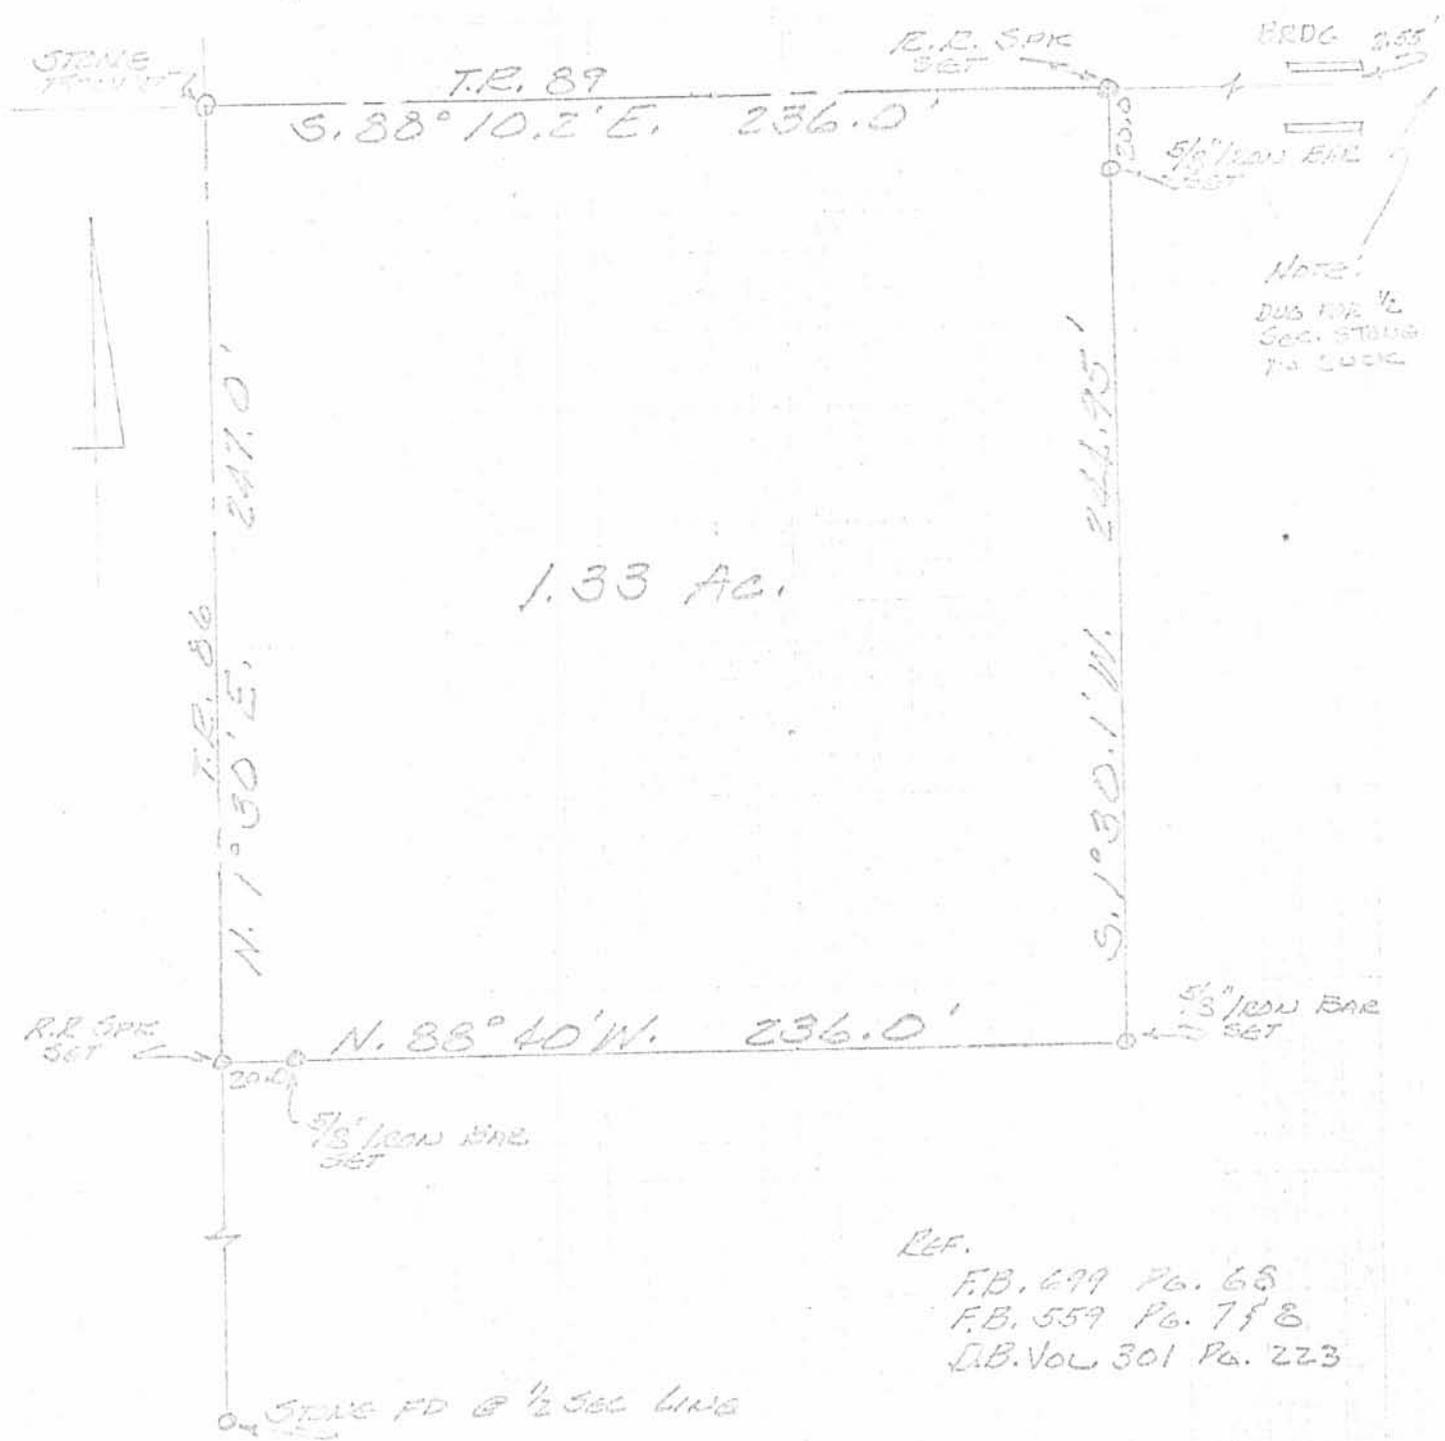

Note:  
DUB FOR 1/2  
SEC. STAKE  
TO LOCK

1.33 AC.

Ref.  
F.B. 499 Pg. 65  
F.B. 559 Pg. 7 & 8  
D.B. Vol. 301 Pg. 223

STONE FD @ 1/2 SEC LINE

**NOLTE SURVEY**  
Sec. 17 T. 6 S. R. 8 E.  
STORES TOWNSHIP  
LOGAN COUNTY, OHIO  
AUGUST 26, 1975  
SCALE 1" = 50'

5823 1P

INDEXED ON MAP

LESLIE H. GOSLIN  
REG. SURVEYOR 5243  
RUSHSVLVANIA, OHIO