


CHANNEL - INDIAN LAKE

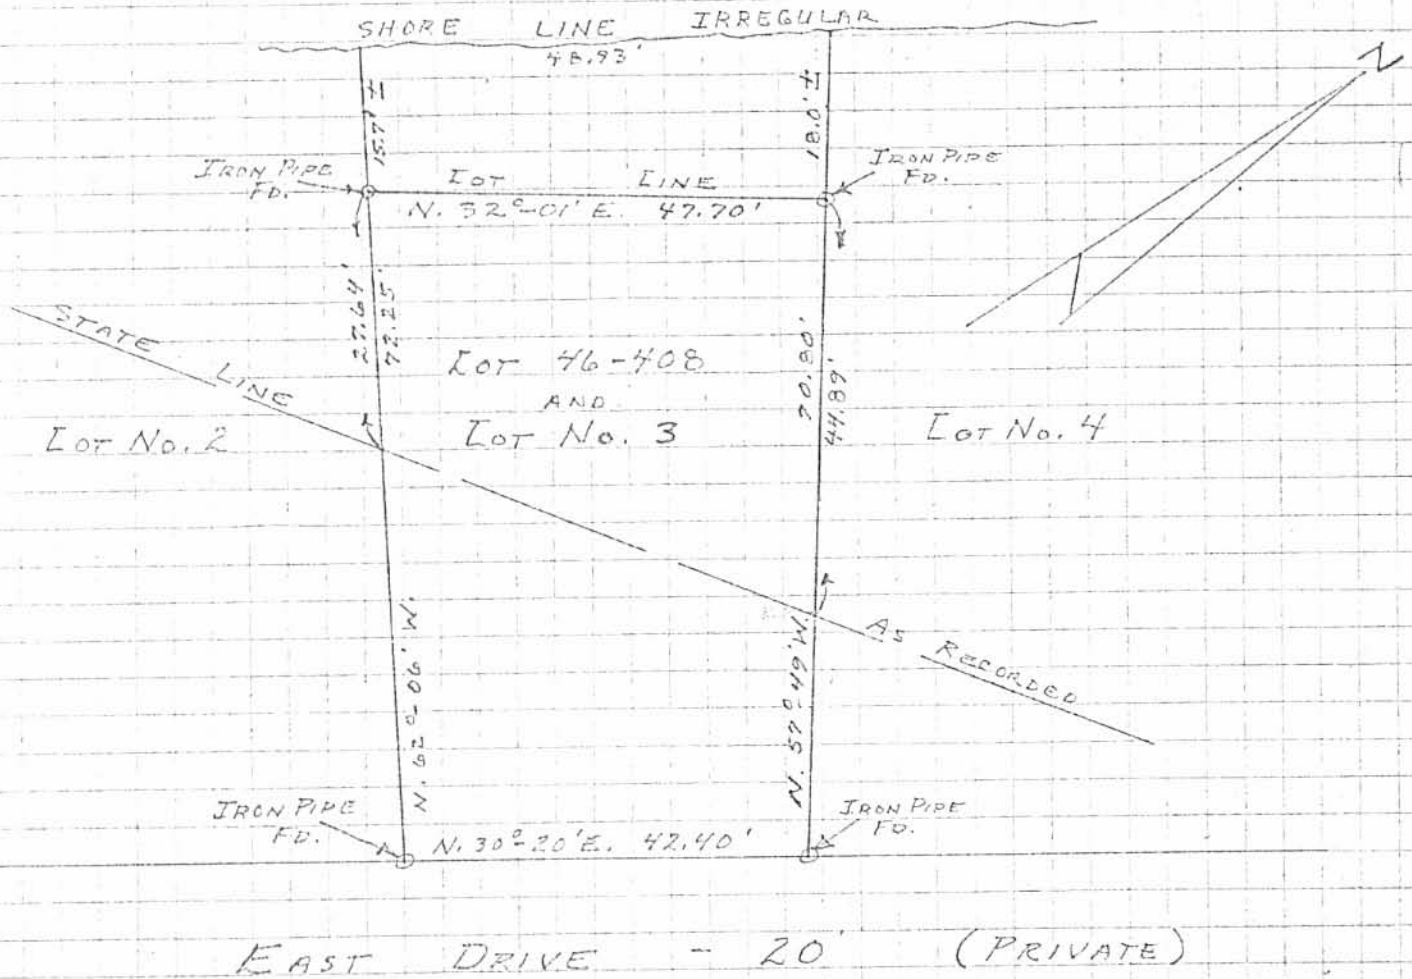

SURVEY OF Lot No. 3  
 AND Lot 46-408  
 NEWLAND ALLOTMENT  
 V.M.S. No. 12277  
 STOKES TOWNSHIP  
 LOGAN COUNTY, OHIO  
 SEPTEMBER 13, 1975

SCALE: 1" = 20'

SURVEYED AND PLATED BY:  
 DANIEL E. GILBERT, P.S.  
 REG. SUR. No. 5402  
 1041 N. MAIN ST.  
 BELLEFONTAINE, OHIO  
 43311

5825 1P

INDEXED ON MAP