


STILES SURVEY
H. L. WILLIAMS TRACT
Sec.27 T-6s R-8e
STOKES TOWNSHIP
October 5, 1968

The following described real estate situated in Stokes Township,
Logan County, Ohio and being part of the northwest ^{EAST} 1/4 of Section
27, Town 6 south, Range 8 east of the First Principal Meridian
and also being part of H. L. Williams unrecorded subdivision and
more particularly described as follows:

Commencing at an iron bar at the northeast corner of Francis H.
Kirkman's 0.11 acre tract and in the west line of a private street;
thence with the west line of said street N.0° 48'E. 66.0 feet to
an iron bar, said iron bar being the beginning point of this
description; thence continuing with said west line N.0° 48'E. 65.9
feet to an iron bar; thence N.89° 24'W. 100.4 feet to a 15 inch
oak at the northeast corner of Eldon M. Grubbs' 0.27 acre tract;
thence with said Grubbs' east line South 65.8 feet to an iron bar;
thence S.89° 20'E. 99.5 feet to the place of beginning.

Containing 0.15 of an acre more or less.

INDEXED ON MAP
5879 1D

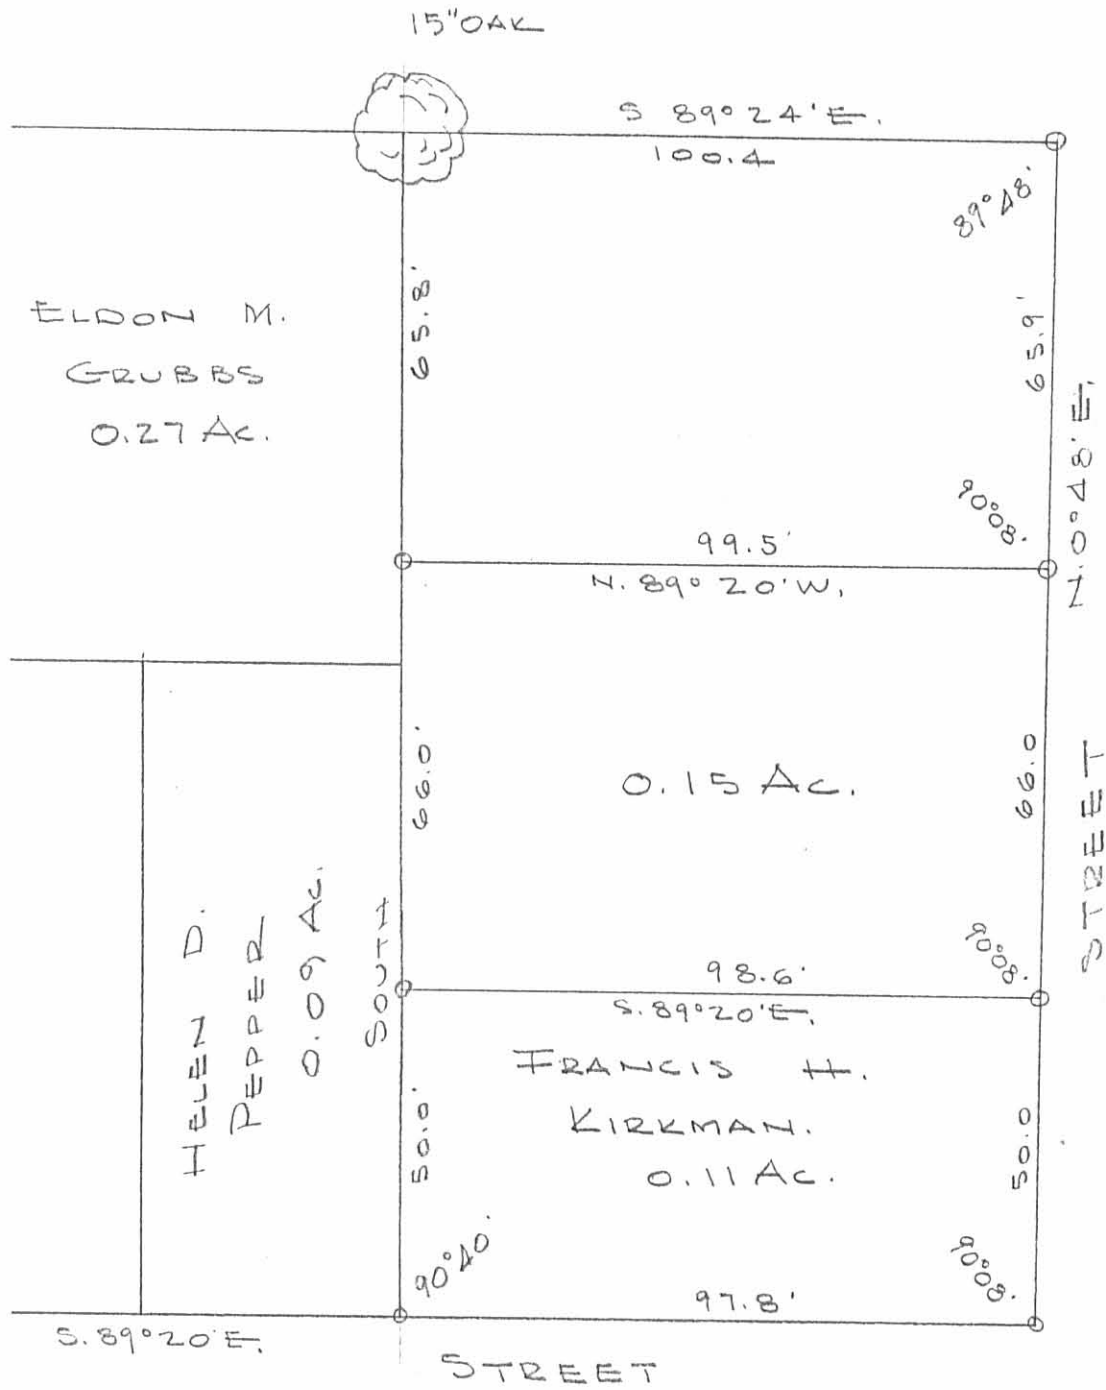

STILEE SURVEY
 SEC. 27 T-6S. R-8E.
 STOKES TOWNSHIP
 LOGAN COUNTY, OHIO
 OCT. 5, 1968
 SCALE 1" = 30'
 0 = 5/8" φ BAR SET

INDEXED ON MAP
 5879 1P

DAN L. DODSON
 REG. SURVEYOR 4270
 BELLEFONTAINE, O.

Blosser & Associates
P.O. BOX 591 BELLEFONTAINE, OHIO
43311

Deed Description : Situated in the County of Logan, in the State of Ohio, and in the Township of Stokes:
Being part of the northwest ^{EAST} $\frac{1}{4}$ of Section 27, Town 6 south, Range 8 east of the First Principal Meridian and also being part of H. L. Williams unrecorded subdivision and more particularly described as follows:

Beginning at an iron bar at the northeast corner of Francis H. Kirkman's 0.11 acre tract and in the west line of a private street;
Thence with said Kirkman's north line North 89 Degrees 20 Minutes West 98.70 feet to an iron bar;
Thence with the east line of Helen D. Pepper's 0.09 acre tract North 66.1 feet to an iron bar;
Thence South 89 Degrees 20 Minutes East 99.50 feet to an iron bar at the southeast corner of Ulysses G. Fannin's 0.15 Acre tract;
Thence with the west line of a private street South 0 Degrees 48 Minutes West 66.00 feet to the point of beginning;
Containing 0.15 acres more or less.

Surveyed July 1, 1975

By Larry E. Blosser SIT # 1199

Checked By:

L. E. Maguire
Registered Surveyor # 3151

INDEXED ON MAP

5879 2D

PRIVATE STREET

LESTER PEPPER SR.
0.27 AC.

LEWIS D. PEPPER
0.08

ULYSSES G. FANNIN
0.15 AC.

Set
IRON-PIPE

FD-IRON

S. 89° 20' E. 99.50

FD-PIPE

NORTH 66.10

0.15 ACRE

S. 0° 48' W. 66.00

FD-IRON

N. 89° 20' W. 98.70

FD-IRON

FRANCIS H. KIRKMAN
0.11

5879 2P

INDEXED ON MAP

SURVEY OF JOHN W. JONES 0.15 ACRE TRACT
SECTION 27, TOWN 6 S, RANGE 8 E
STOKES TWP., LOGAN CO., OHIO

SCALE 1"=20'

SURVEYED JULY 1, 1975
BY L. BLOSSER SIT # 1199

Cecil E. Mangum
Reg. Surv. # 3151