


CLAY SURVEY - LOTS 272 thru 277 AVONDALE ALLOT. #3
 STOKES TWP., LOGAN CO., OHIO - INDIAN LAKE AREA

L.H.G. survey
 Lo. Co. File No. 59225

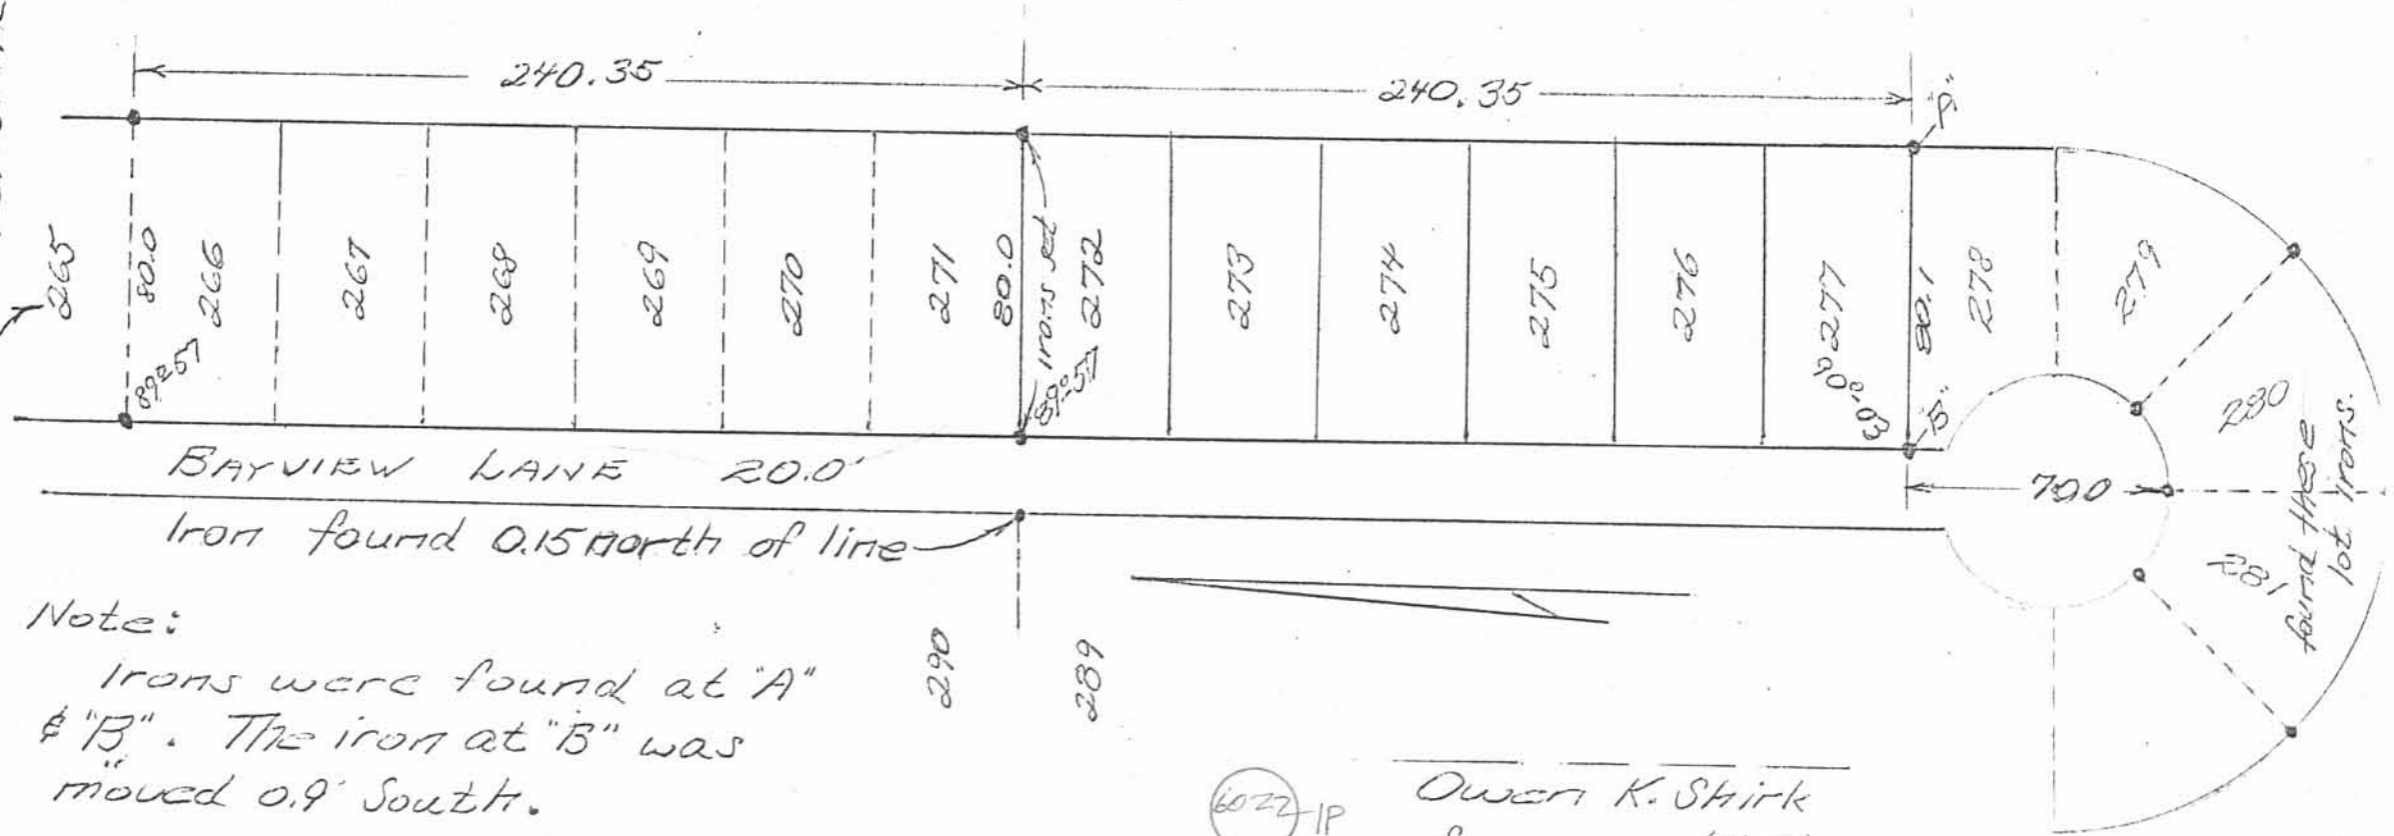

Note:
 Irons were found at "A"
 & "B". The iron at "B" was
 moved 0.9' South.

6022-1P

Owen K. Stirk
 Surveyor #271
 April 7, 1977

INDEXED ON MAP

Lot 278 - 279
 AVOUDALE No. 3

- A = $5/8"$ ϕ Bars Found - See Survey
 index 5925
- B = $1"$ ϕ Bar Found & Used
- C = $5/8"$ ϕ Bar Set 0.9' North of
 $1"$ ϕ Bar Found
- D = $5/8"$ ϕ Bars Set

LINE B-C (NORTH LINE OF LOT 278) IS
 IN DISPUTE - OWNER OF 277
 CLAIMS $1"$ ϕ Bar at B & $1"$ ϕ Bar at C
 ARE CORRECT LINE -

NORTH LINE OF LOT 278 RAISED TO
 CONFORM TO $1"$ ϕ Bar @ "C"
 D.L.D.

INDEXED ON MAP
 6022

Dodson
 Antis

3/26/77
 65°±

39

