

LESLIE H. GEESLIN
REGISTERED SURVEYOR NO. 5248
P. O. BOX 274
RUSHSVLVANIA, OHIO 43347

TELEPHONE: (513) 468-2793
PENN-CENTRAL PROPERTIES

TO

LOGAN COUNTY

August, 1983

The following described real estate situated in the State of Ohio, County of Logan, Township of Stokes, being part of the northwest $\frac{1}{4}$ of Section 34, Town 6 S., Range 8 E. and more particularly described as follows:


Beginning at an iron bar at Station 1738 plus 43.20 in the west corporation line of the Village of Lakeview and the south right-of-way line of the old T. & O. C. Railroad; thence with said south R/W line N. $77^{\circ} 15'$ W. 397.81 feet to an iron bar; thence N. $0^{\circ} 18' 10''$ W. 67.75 feet to an iron bar in the north R/W line; thence with said north R/W line S. $77^{\circ} 15'$ E. 397.88 feet to an iron bar in the west corporation line of said village; thence with said corporation line S. $0^{\circ} 15' 34''$ E. 67.74 feet to the place of beginning.

Containing 0.603 acre more or less.

6887 1D

INDEXED ON MAP

SALOME E. MYERS
5.98 AC.

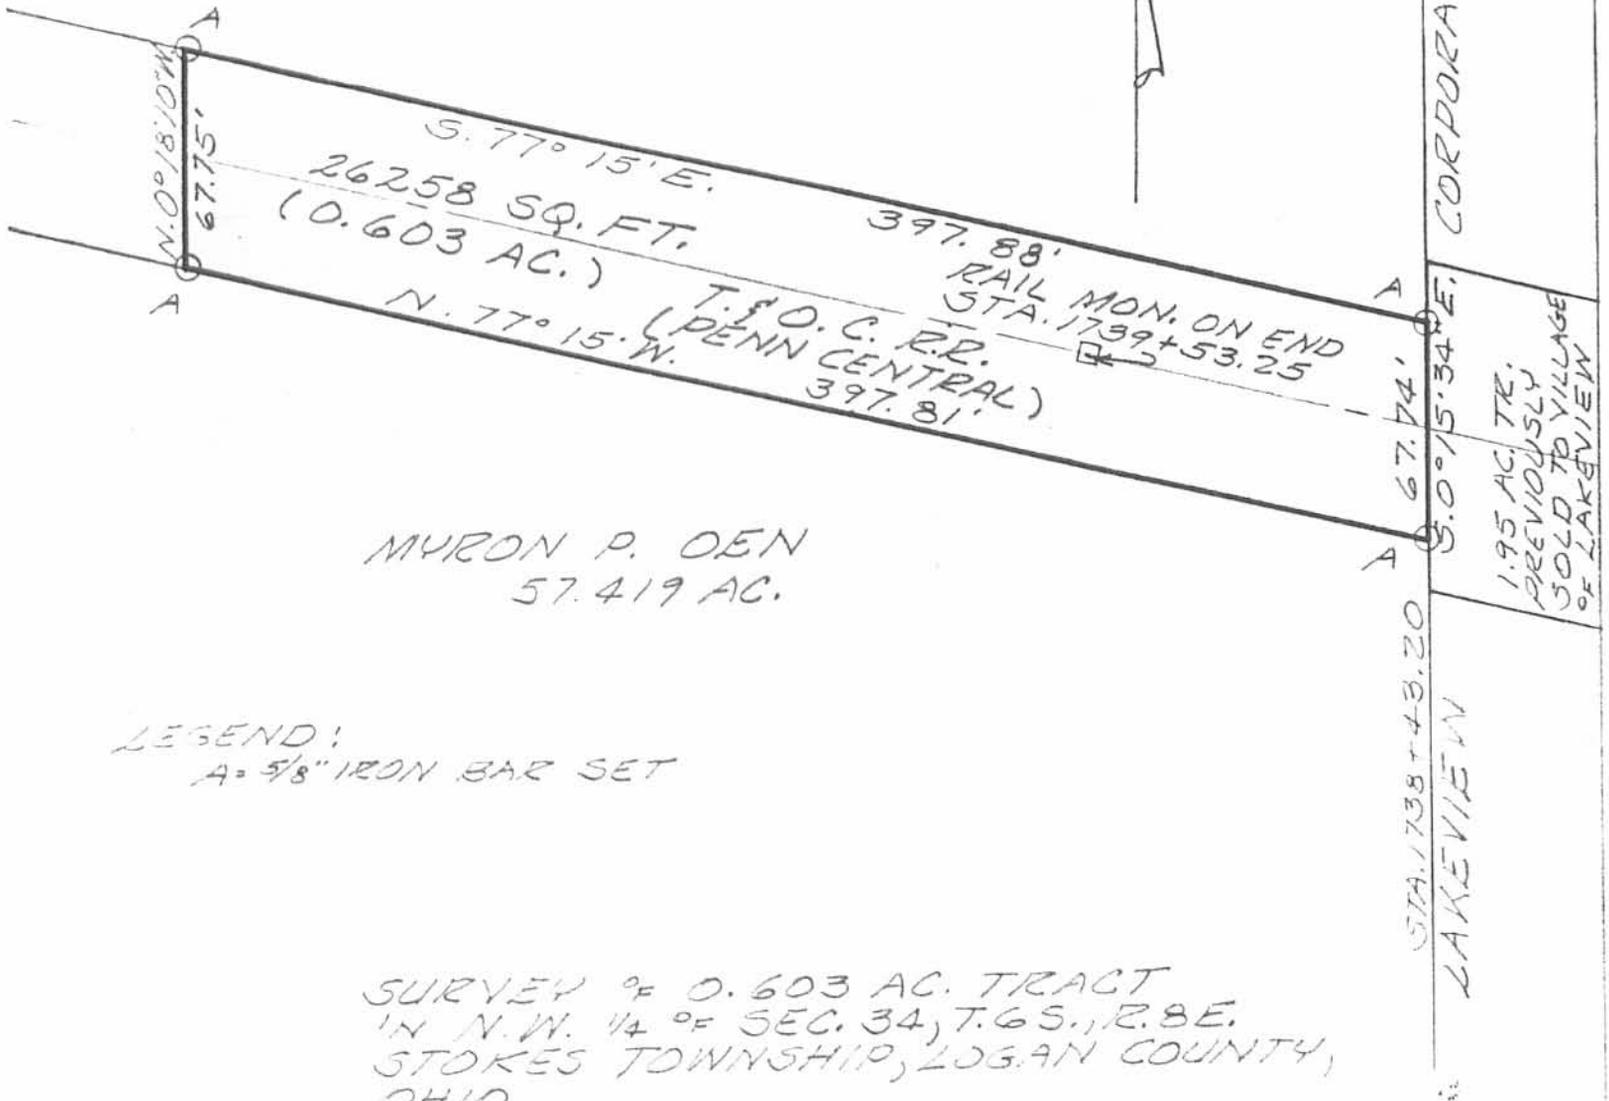

MURON P. OEN
57.419 AC.

LEGEND:
A = 5/8" IRON BAR SET

SURVEY OF 0.603 AC. TRACT
IN N.W. 1/4 OF SEC. 34, T.6S., R.8E.
STOKES TOWNSHIP, LOGAN COUNTY,
OHIO.

AUGUST, 1983
SCALE: 1"=60'

THIS SURVEY CERTIFIED AS TO
CORRECTNESS TO THE PENN.-CENTRAL
CORPORATION AND TO THE TITLE
INSURANCE COMPANY INSURING
THEIR INTERESTS IN THE
PREMISES.



6887 IP

INDEXED ON MAP



Leslie H. Geeslin
SURVEYED BY: LESLIE H. GEESLIN
RUSHSVLVANIA, OHIO