

Immell Description

The following described real estate situated in the Township of Stokes, County of Logan, State of Ohio and being a part of Virginia Military Survey No. 12276 on Seminole Island in Indian Lake and being more particularly described as follows:

Beginning at an iron bar at the northwest corner to Norman C. Milliser's present 0.30 Acre tract as described in Deed Volume 369 Page 530 of the Deed Records of Logan County, Ohio and also being in the south right of way line of proposed Wyandot Drive (which is 50.00 feet wide);

Thence with Milliser's west line, S. $25^{\circ} 07'$  W. 120.00 feet to an iron bar at Milliser's southwest corner;

Thence with an extension of Milliser's south line, N.  $62^{\circ} 24'$  W. 60.00 feet to a point;

Thence north and parallel with the west line of Milliser's tract, N.  $25^{\circ} 07'$  E. 120.00 feet to a point in the south right of way line of proposed Wyandot Drive;


Thence with the south right of way line of proposed Wyandot Drive, S.  $62^{\circ} 24'$  E. 60.00 feet to the place of beginning, containing 0.17 Acres, more or less.

The above being described tract being put of Tract C of 0.248 Acres as surveyed by me on May 20, 1978. This tract being prepared from that survey on May 5, 1983.


I hereby certify that this is a true and accurate description as prepared by me on May 5, 1983.



INDEXED ON MAP

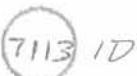

*Daniel E. Gilbert*  
Daniel E. Gilbert, P.S.  
Reg. Sur. No. 5402  
1041 N. Main St.  
Bellefontaine, Ohio 43311

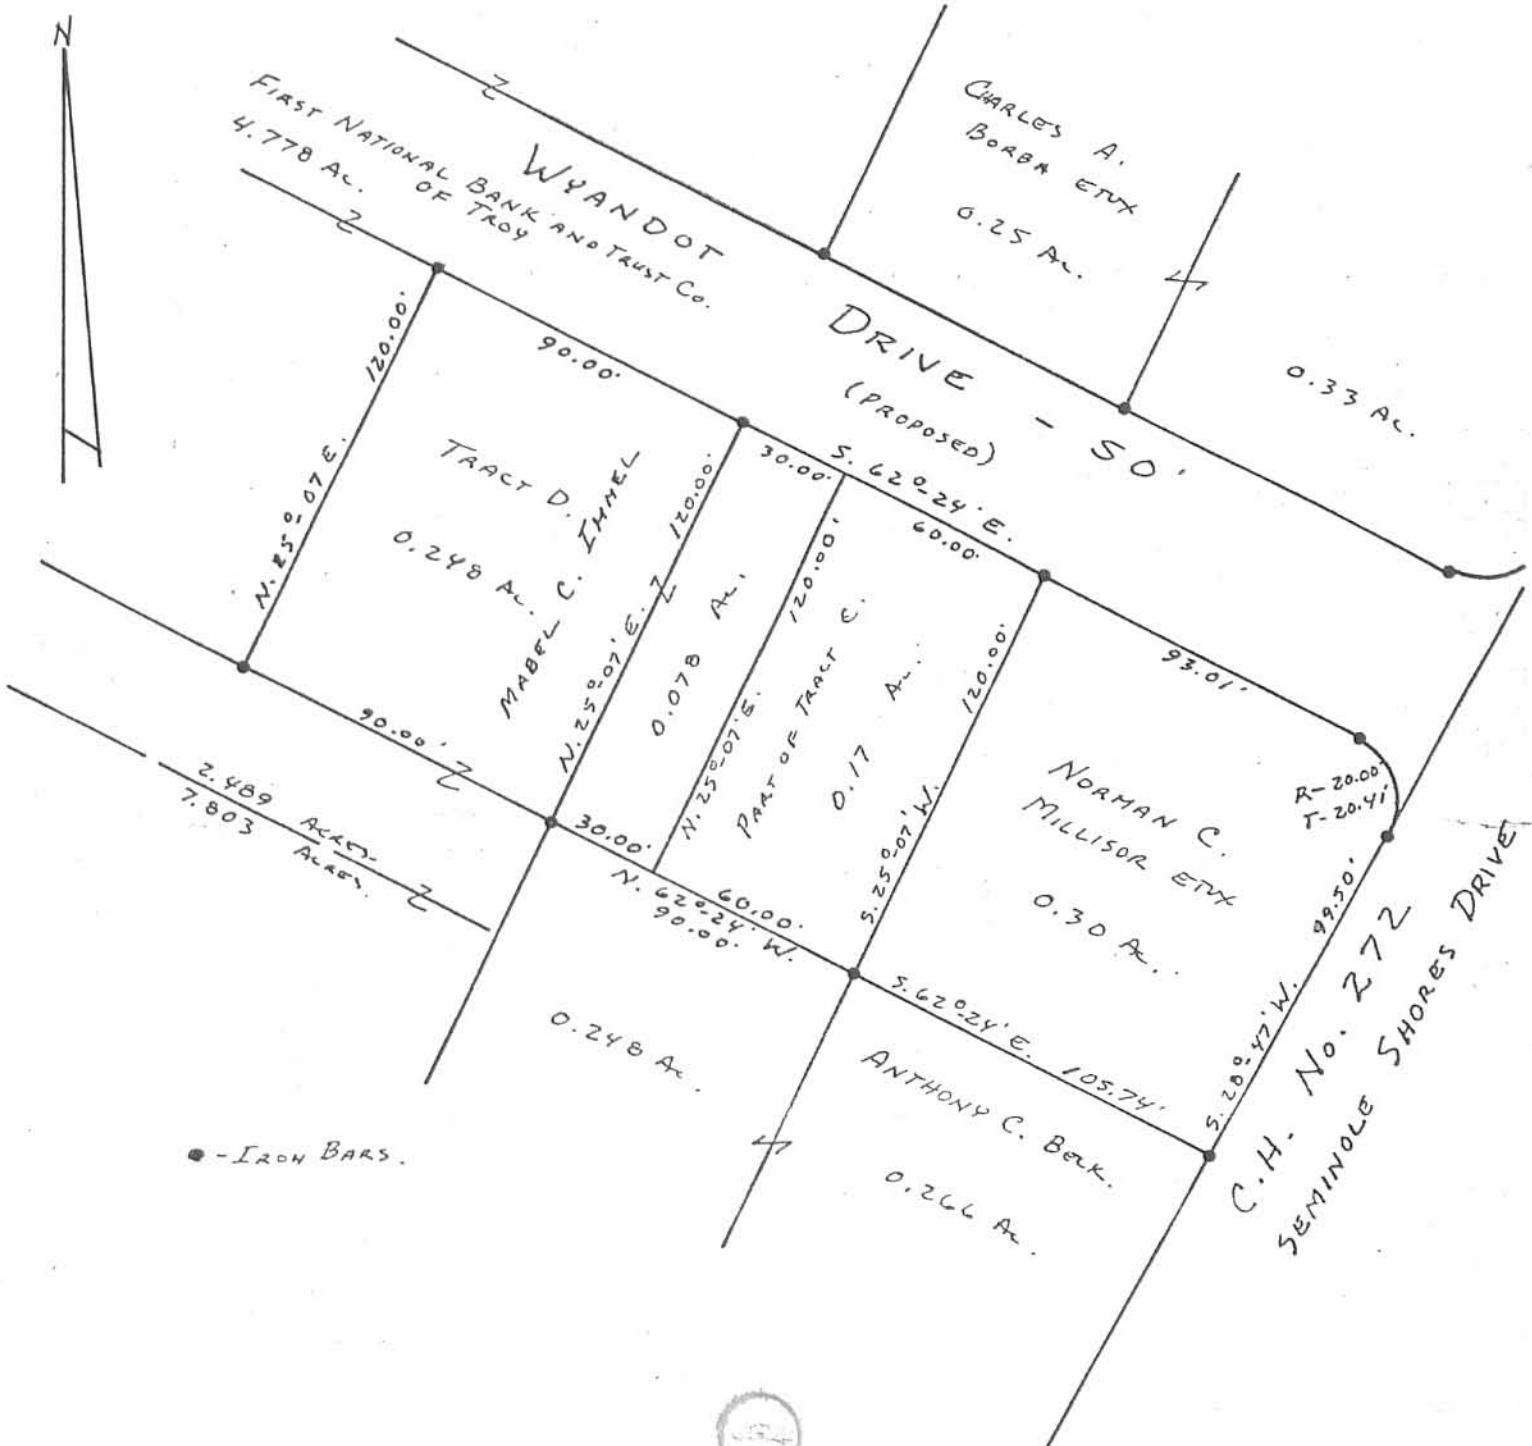

SURVEYED AND PLATTED BY:  
DANIEL E. GILBERT, P.S.  
REG. SUR. NO. 5402  
1041 N. MAIN ST.  
BELLEFONTEAINE, OHIO 43311

IMMEL SURVEY  
V.M.S. NO. 12276  
SEMINOLE ISLAND  
STOKES TOWNSHIP  
LOGAN COUNTY, OHIO  
MAY 5, 1983

SCALE: 1"=50'