

MAUK SURVEY
Sec.23 T-6s. R-8e.
STOKES TOWNSHIP
October 18, 1969


The following described real estate situated in Stokes Township, Logan County, Ohio and being part of Section 223, Town 6 south, Range 8 east of the First Principal Meridian and more particularly described as follows:

Commencing at an iron bar at the northeast corner of Lot No. 17 of Cherokee Allotment as shown in Logan County Recorders Plat Book C, Volume 3, Page 66; thence S.33° 04'E. 191.7 feet to an iron bar, said iron bar being the beginning point of this description; thence continuing S.33° 04'E. 100.0 feet to an iron bar; thence S.56° 56'W. 50.0 feet to an iron bar; thence N.38° 47'W. 100.5 feet to an iron bar; thence N.56° 56'E. 60.0 feet to the place of beginning.

Containing 0.13 of an acre more or less.

The above described tract being part of Ralph Mauk's 1.74 acre tract.

INDEXED ON MAP
7449 1D

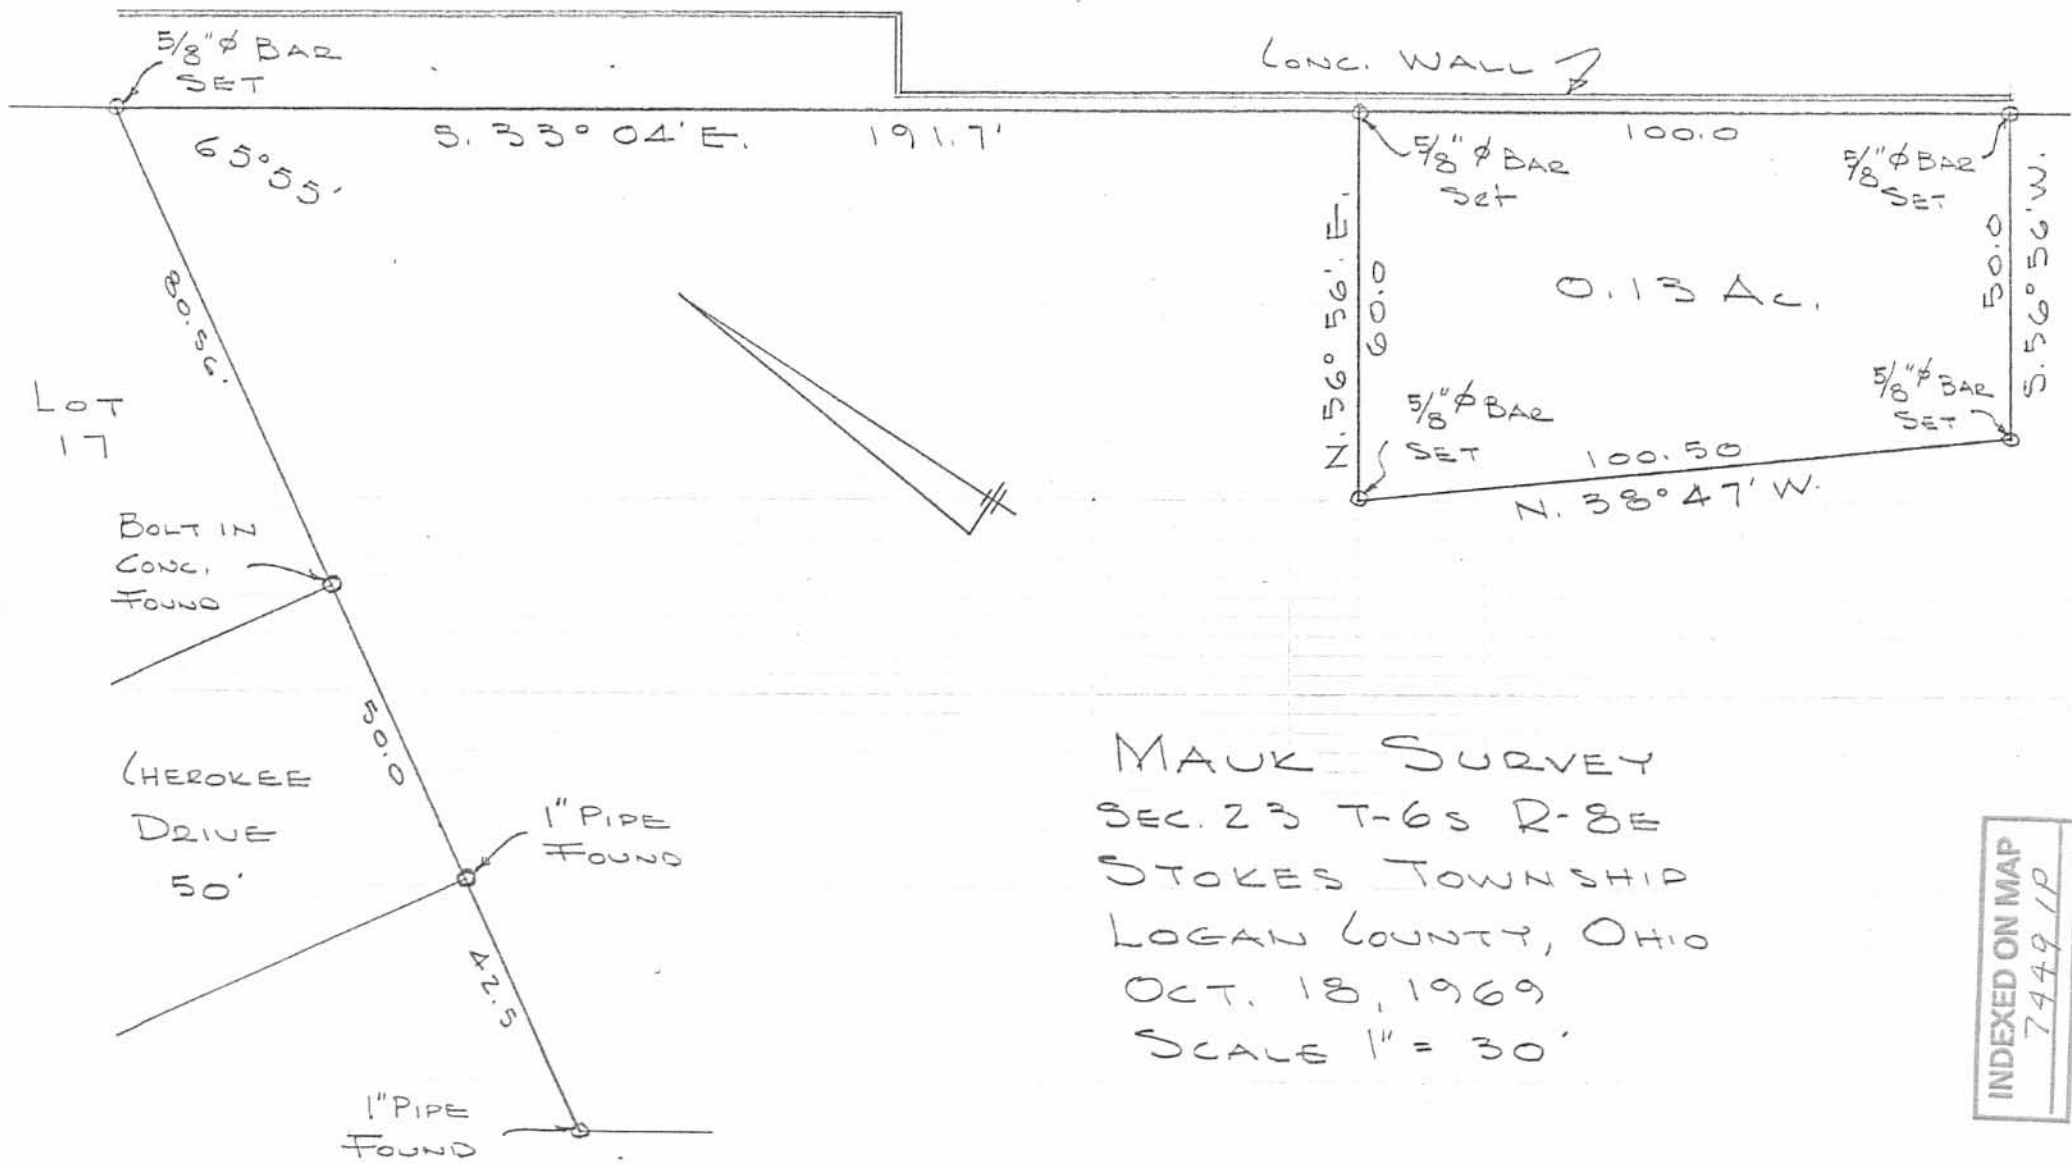

MAUK SURVEY
 SEC. 23 T-6S R-8E
 STOKES TOWNSHIP
 LOGAN COUNTY, OHIO
 OCT. 18, 1969
 SCALE 1" = 30'

INDEXED ON MAP
 7449 IP

DAN L. DODSON
 REG. SURVEYOR 4270