


7474

LESLIE H. GEESLIN
P. O. Box 274
RUSHSVLVANIA, OHIO 43347
(513) 468-2793

JOB CHIPPEWA PARK (SURVEY POINT RE.)
SHEET NO. STOKES TWP. OF (PLAT PAGE 52-53)
LOGAN Co.
CALCULATED BY _____ DATE _____
CHECKED BY _____ DATE DRAWN BY: D.L.G.
SCALE _____ 1-28-86

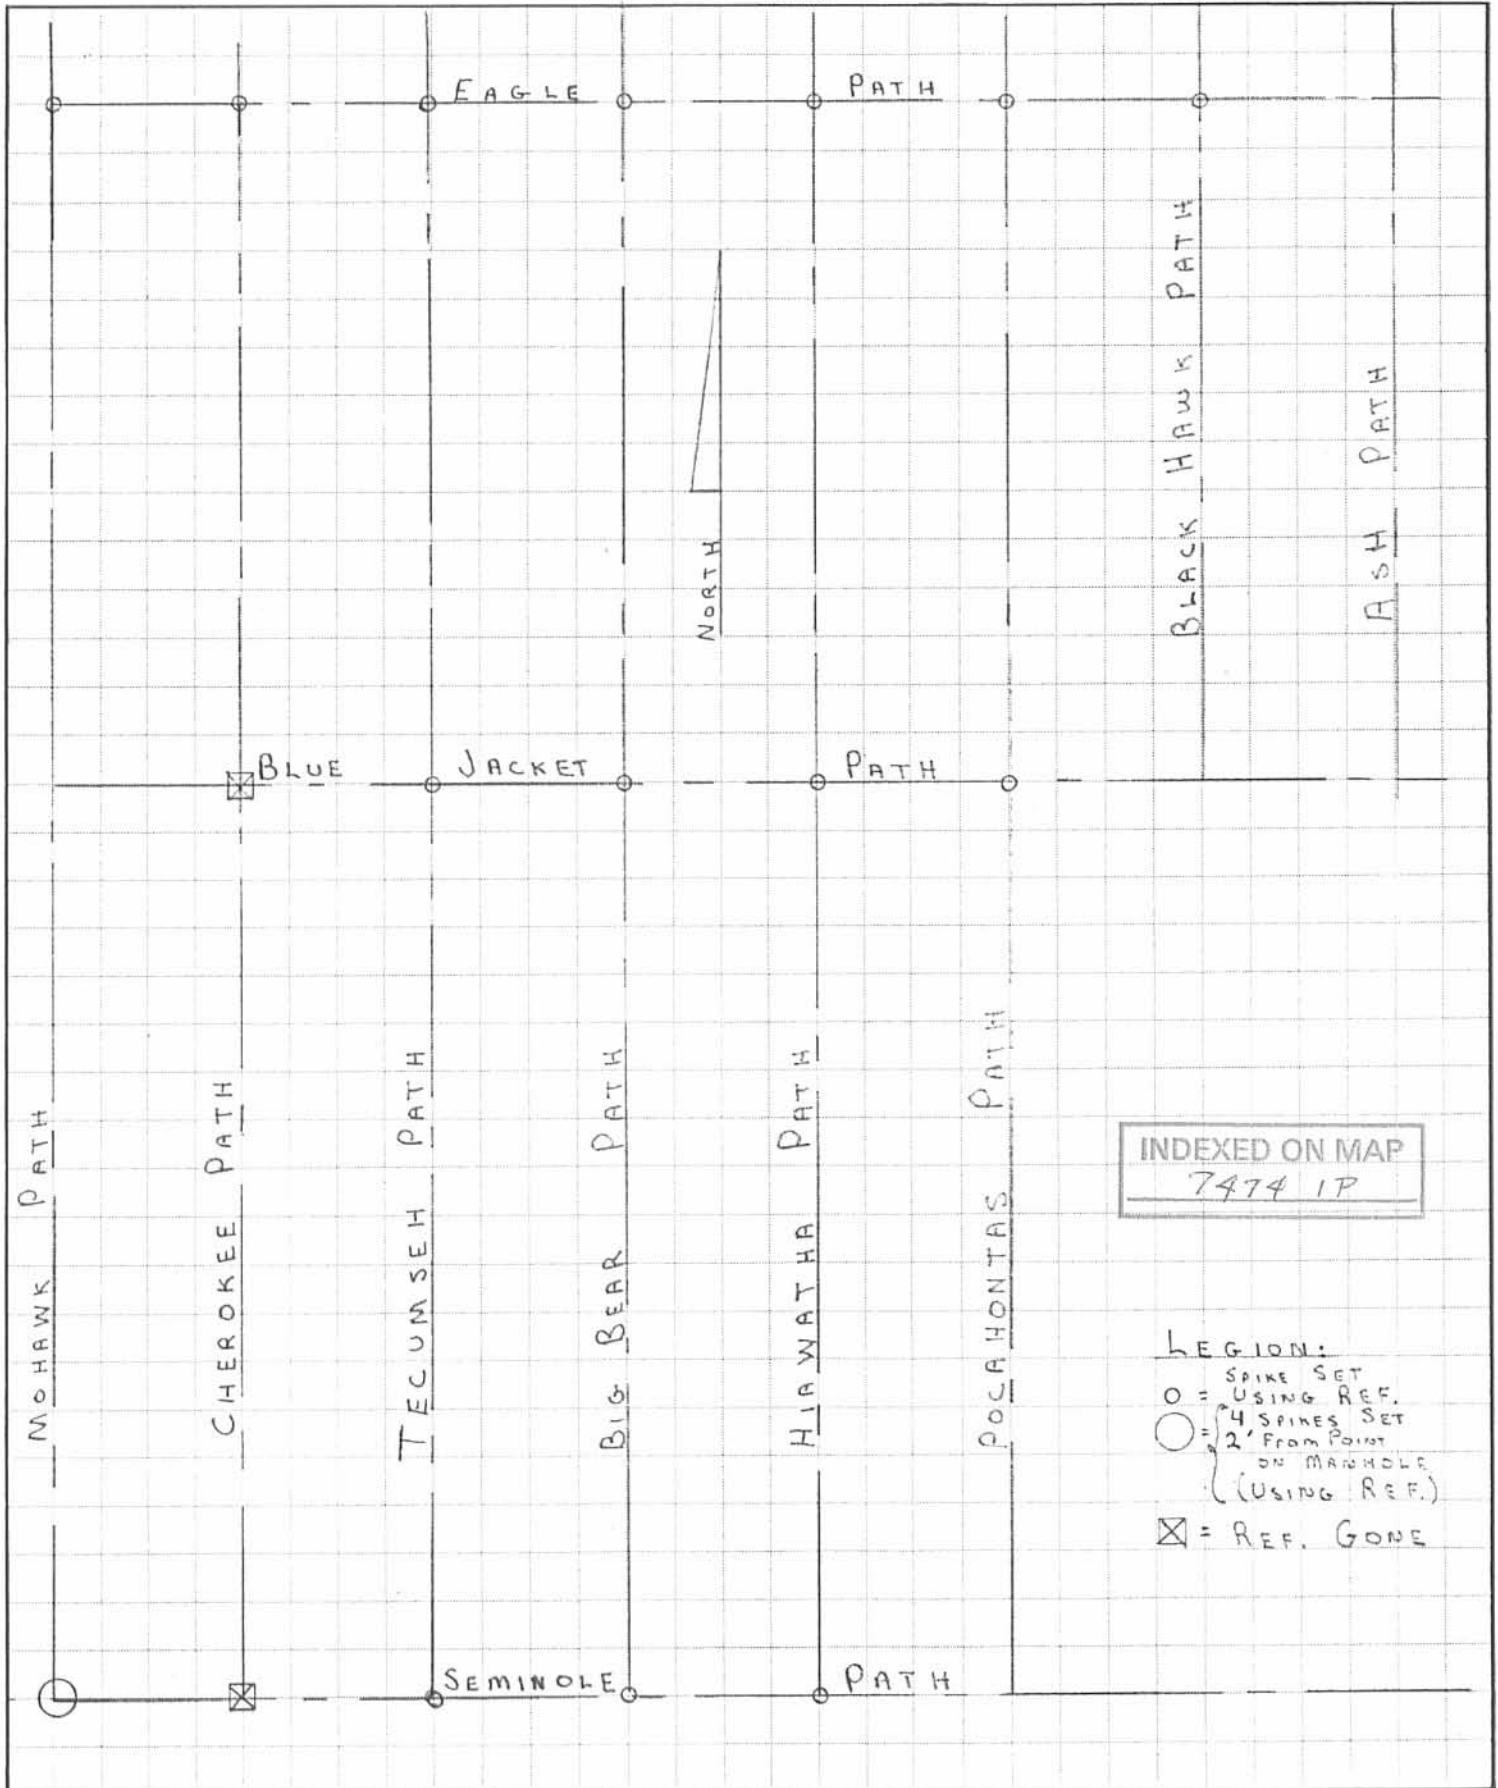

LESLIE H. GEESLIN
P. O. Box 274
RUSHSVLVANIA, OHIO 43347
(513) 468-2793

JOB C. HIPPEWA PARK (SURVEY POINT RE.)
STOKES TWP. (PLAT PAGE 51)

SHEET NO. V.M.S. 12276 OF _____

CALCULATED BY _____ DATE _____

CHECKED BY _____ DATE DRAWN BY: D.L.G.

SCALE _____ 1-28-86

