



LESLIE H. GEESLIN
P. O. Box 274
RUSHSVLVANIA, OHIO 43347
(513) 468-2793

JOB ISLAND VIEW (SURVEY POINT REPLACE)
STOKES TWP. - (PLAT PAGE 56)
SHEET NO. V.M.S. 12276 OF _____
LOGAN CO.
CALCULATED BY _____ DATE _____
CHECKED BY _____ DATE 1-24-86
SCALE _____ DRAWN BY D.L.G.

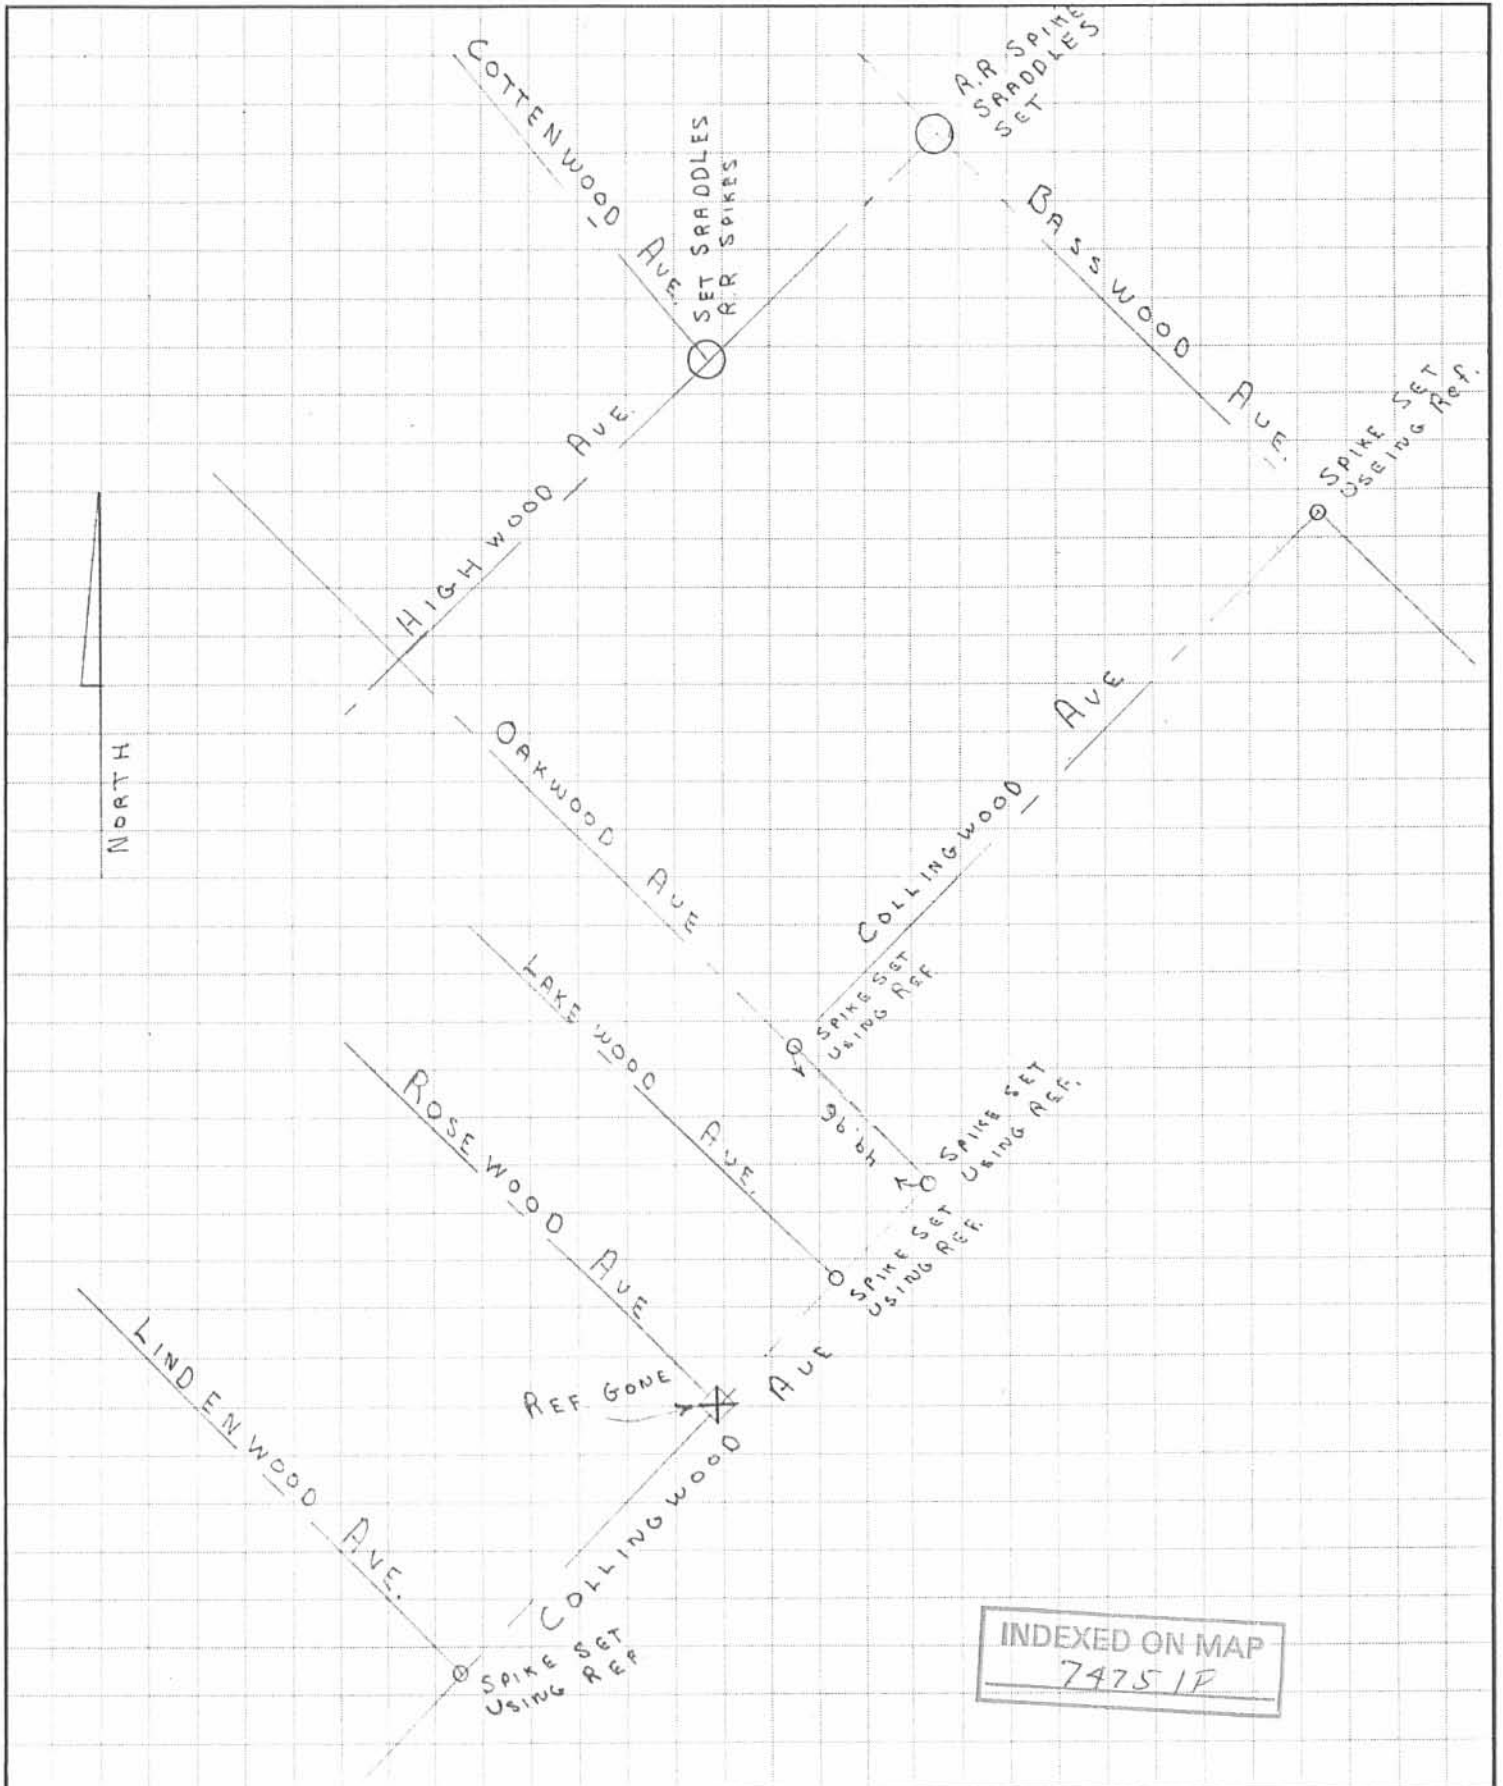

LESLIE H. GEESLIN
P. O. Box 274
RUSHSVLVANIA, OHIO 43347
(513) 468-2793

JOB ISLAND VIEW (SURVEY POINT RE.)
STOKES TWP. PLAT PAGE 56
SHEET NO. LOGAN CO. OF _____
CALCULATED BY _____ DATE _____
CHECKED BY _____ DATE 1-28-86
SCALE _____ DRAWN BY D.L.G.

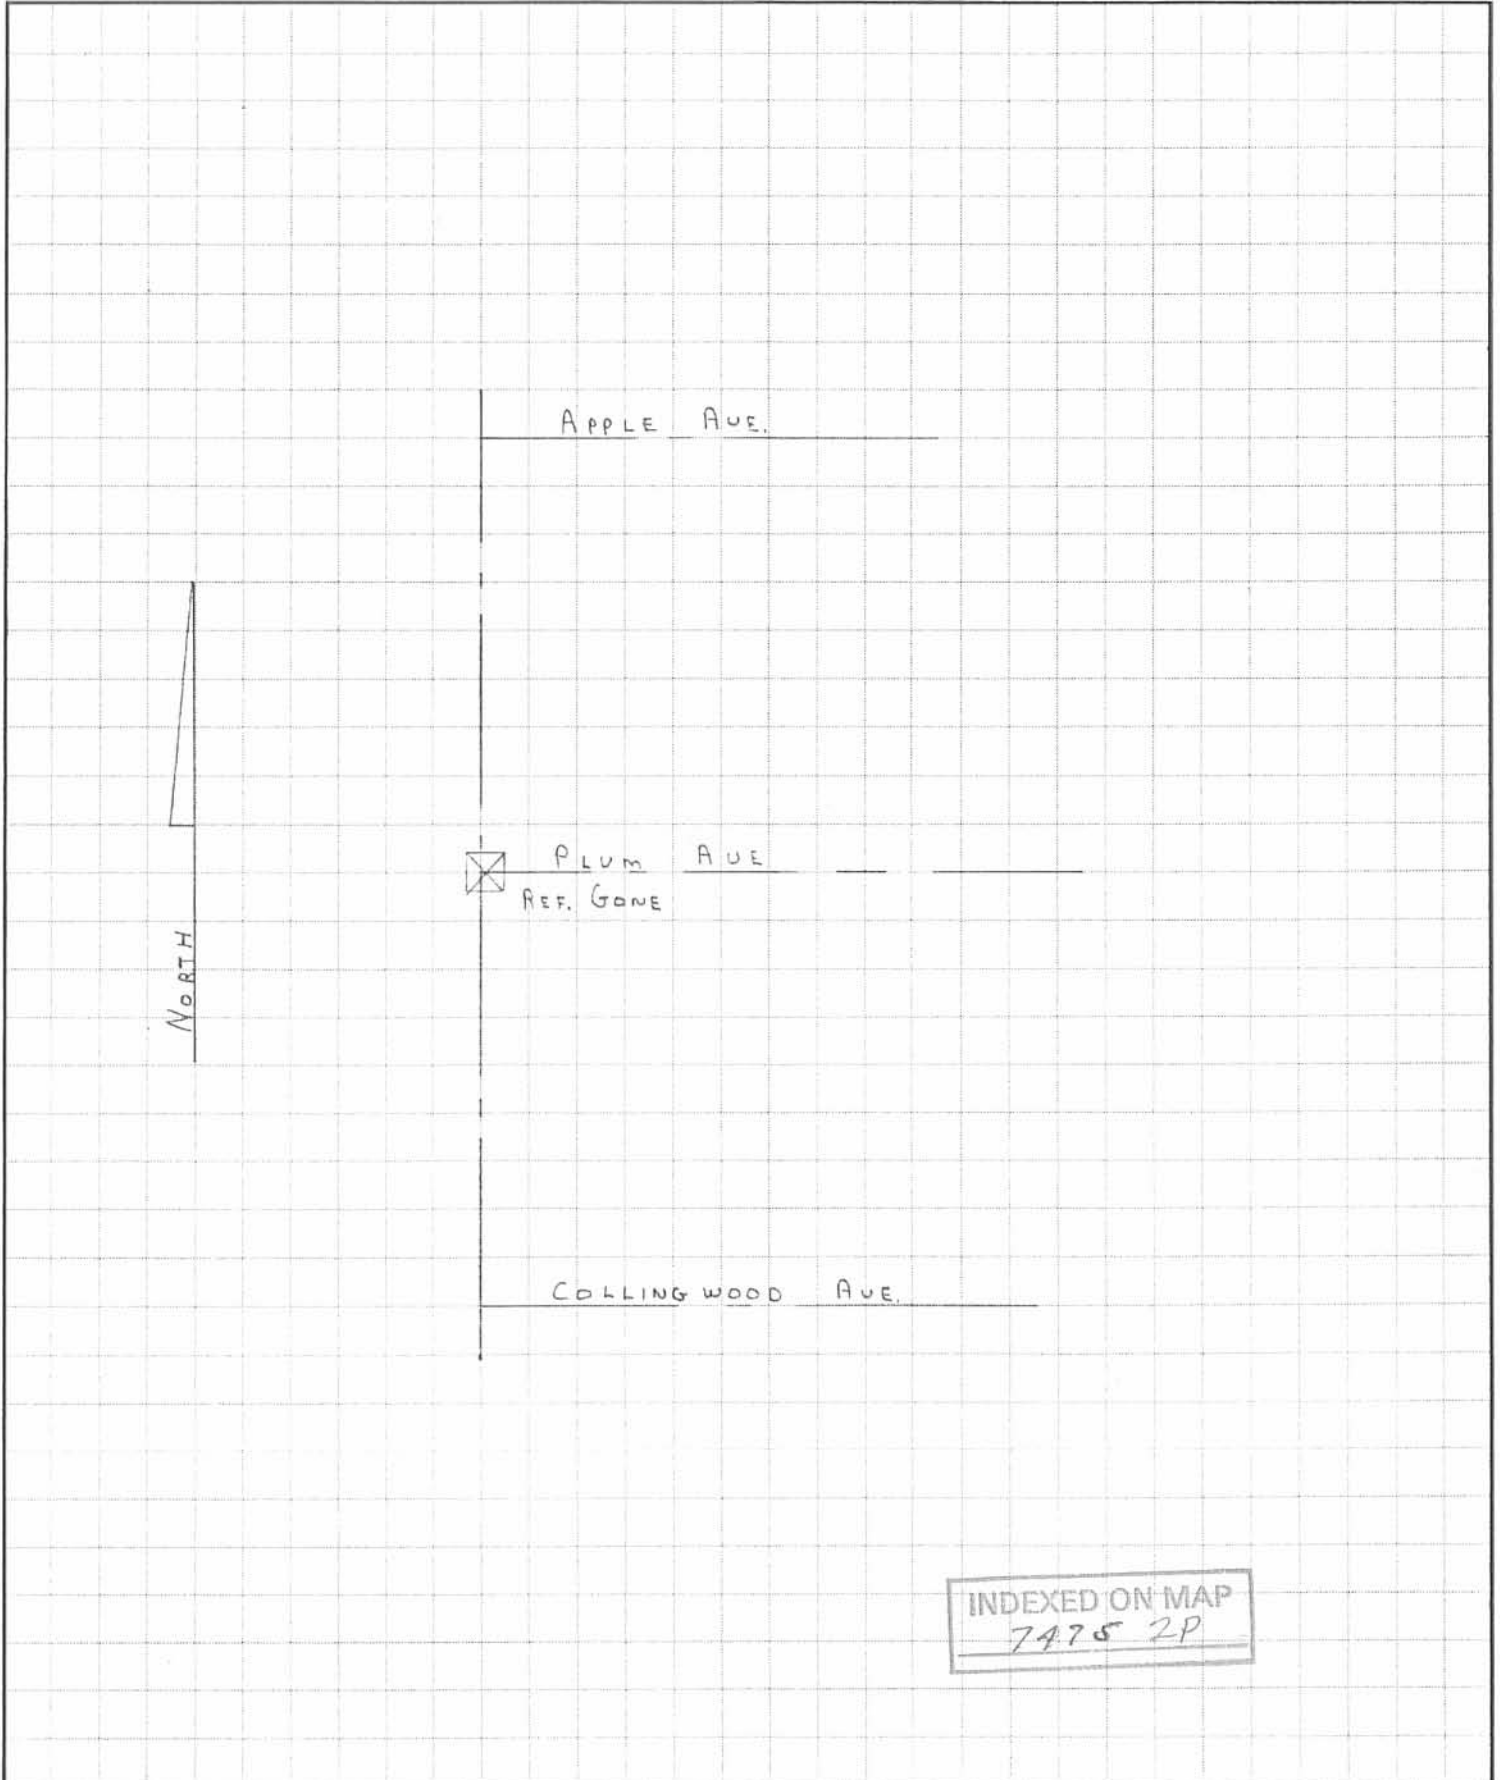

INDEXED ON MAP
7475 2P