
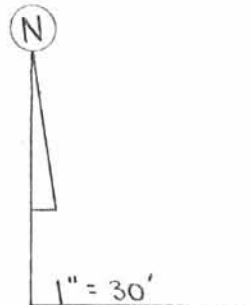


THOMAS DRIVE

SURVEY OF LOT 13 AND
1/2 LOT 14 IN THOMAS ADDITION
No. 4 TO CHIPPEWA PARK,
V.M.S 12276, STOKES TWP.,
LOGAN COUNTY, OHIO.

THOMAS DRIVE

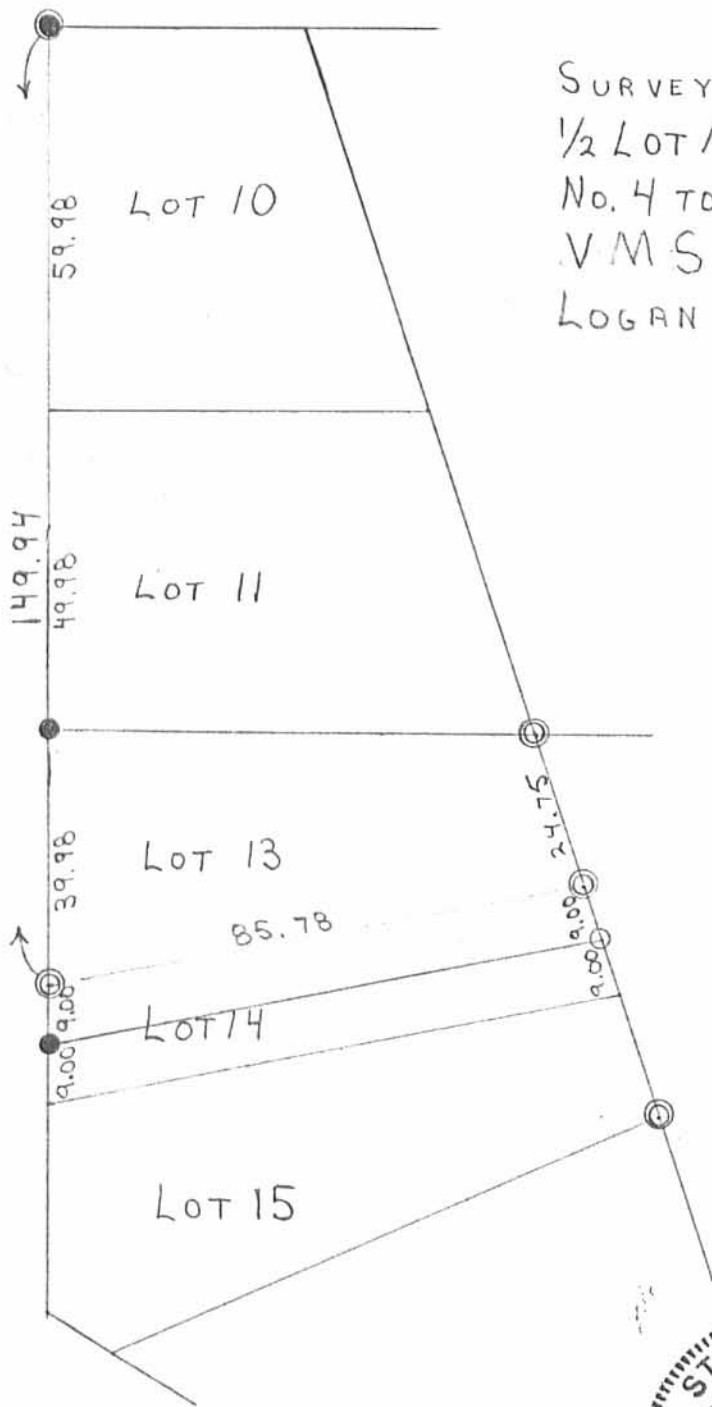

LEGEND:

● = 3/4" PIPE FD.

○ = 1" PIPE FD.

○ = 1/4" PIPE FD.

○ = 5/8" BAR SET



Leslie H. Geeslin

LESLIE H. GEESLIN
RUSHSVLVANIA, OHIO

INDEXED ON MAP
76.52 1P