## LESLIE H. GEESLIN

REGISTERED SURVEYOR NO. 5248
P O. BOX 274

RUSHSYLVANIA, OHIO 43347

TELEPHONE; (513) 468-2793

## WISNIEWSKI SURVEY

October, 1989

The following described real estate situated in the State of Ohio, County of Logan, Township of Stokes, being part of the northeast quarter of Section 28, Town 6 S., Range 8E. and more particularly described as follows:

Beginning at a cap and nail set in the centerline of County Highway 87 and the north line of Section 28 that is WEST 1902.37 feet from a 1 inch iron bolt found at the intersecttion of said C. H. 87 and Township Road 83.

Thence SOUTH 259.00 feet to a 5/8 inch iron bar set, passing a 5/8 inch iron bar set at 20.00 feet.

Thence WEST 185.00 feet to a 5/8 inch iron bar set.

Thence NORTH 259.00 feet to a cap and nail set in the centerline of said C. H. 87 , passing a 5/8 inch iron bar set at 239.00 feet.

Thence with said centerline and the north line of Section 28 EAST 185.00 feet to the place of beginning.

Containing 1.10 acres more or less.


The above described 1.10 acre tract being on the north side of Jerome Meyer's 29.24 acre tract as described in O. R. Vol. 58 Page 53.

Bearings are based on an assumed bearing for C. H. 87 in this field survey.



Jeslin A Masslin



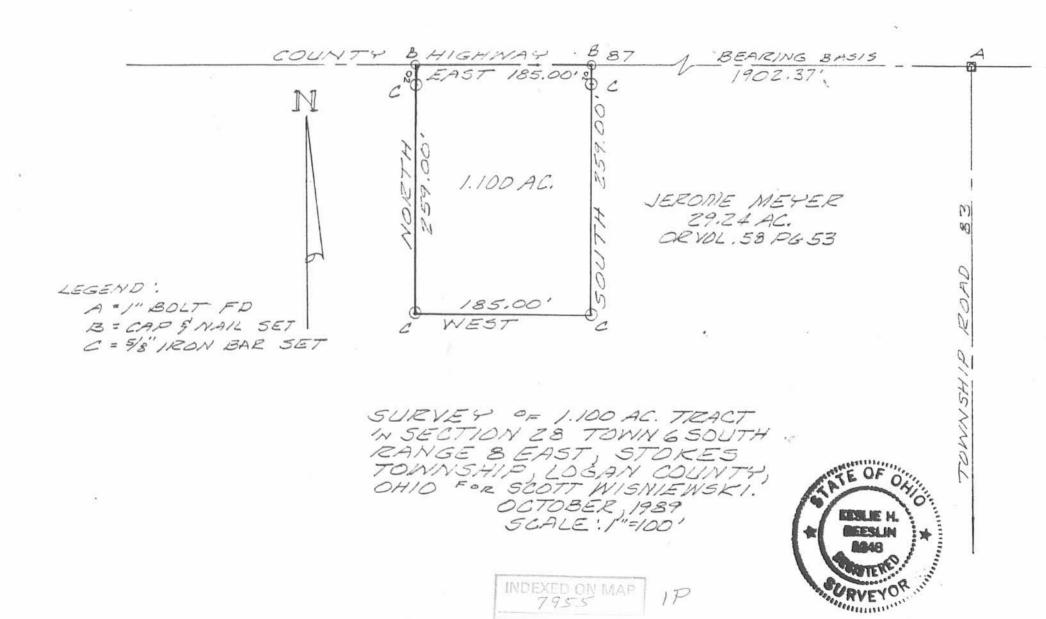

LESLIE H. GEESLIN RUSHSYLVANIA, OHIO