


LEGEND: ● = 5/8" IRON BAR SET  
 ○ = 5/8" IRON BAR FOUND  
 ⊙ = 3/4" PIPE FOUND  
 ▲ = CAP AND NAIL SET  
 SCALE: 1" = 30'

INDEXED ON MAP  
 8006      IP

SURVEY OF LOTS 35,  
 36, AND 37, SEMINOLE  
 ISLAND, STOKES TWP.,  
 LOGAN COUNTY, OHIO.  
 FOR KYLE SHOEMAKER  
 FEBRUARY, 1990

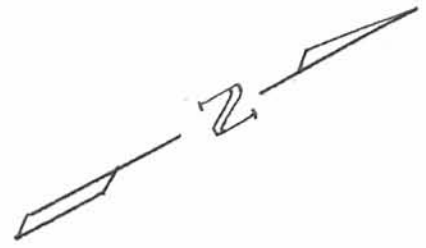

*Leslie H. Geeslin*  
 LESLIE H. GEESLIN  
 RUSHSVLVANIA, OHIO  
 (513) 468-2793