
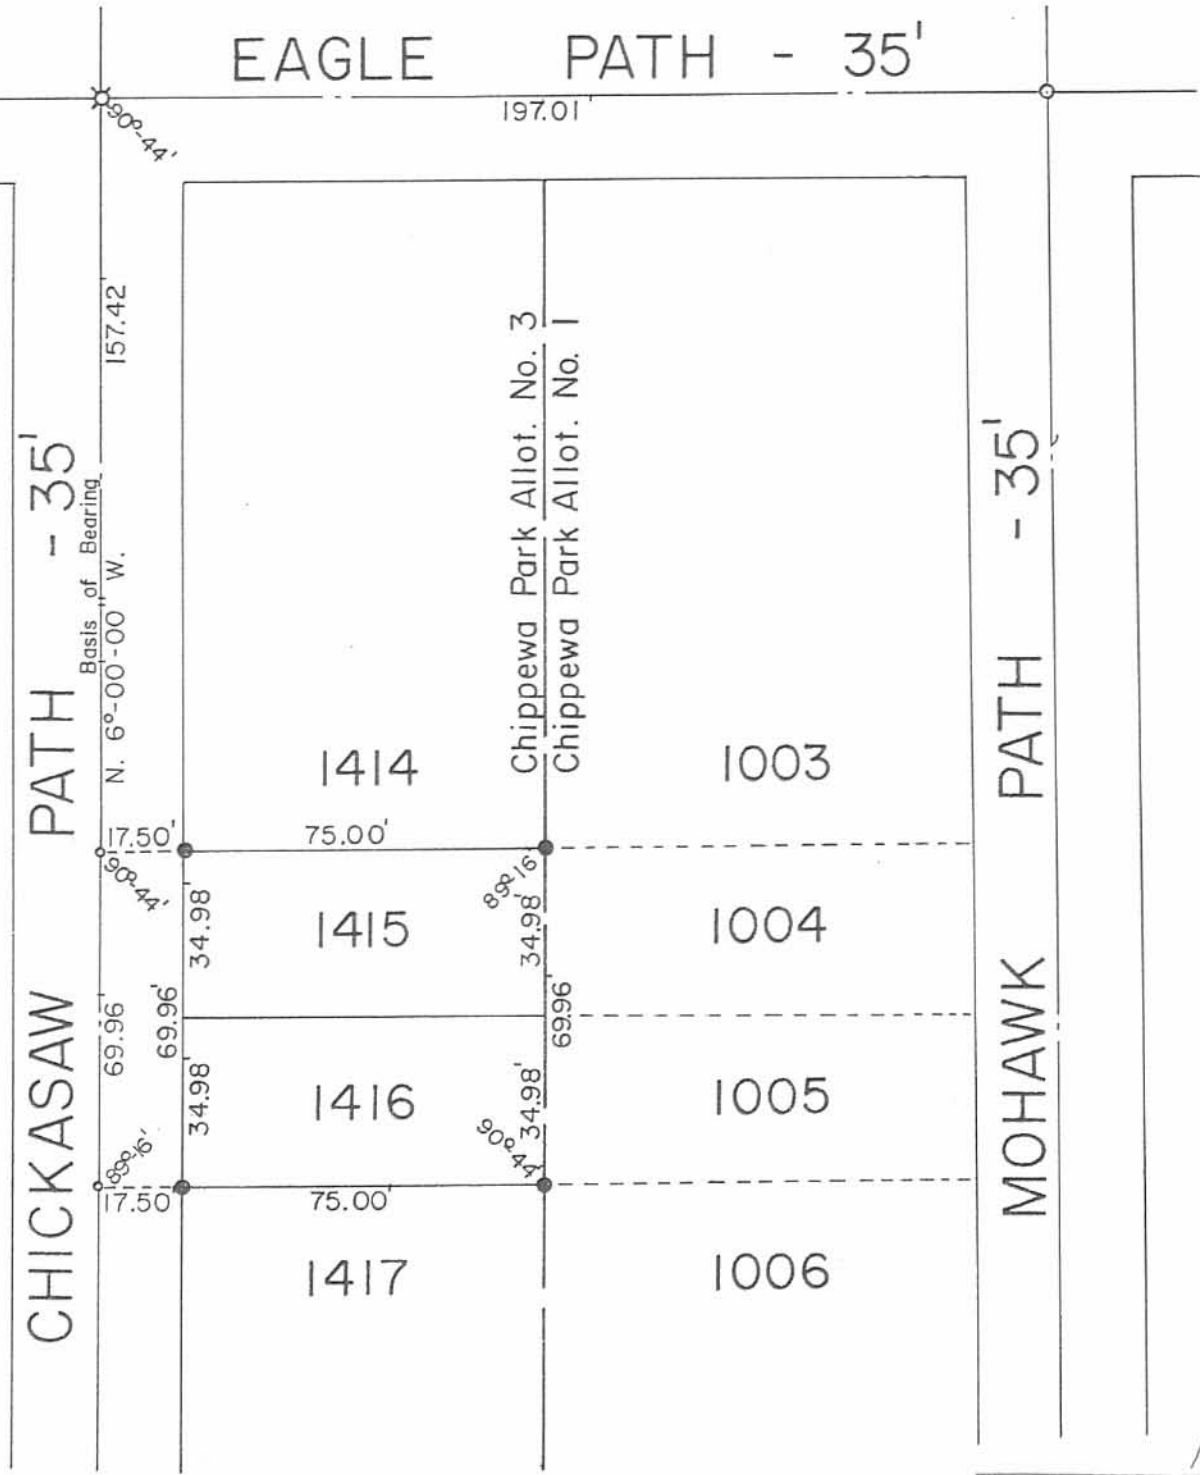


EAGLE PATH - 35'

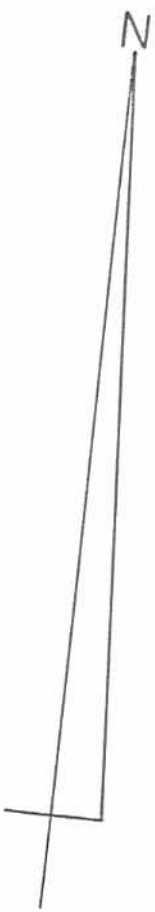

Reference:
 Chippewa Park Allotment No. 1 & 3.
 Plat Cab. A, Slide 221-223.

- Symbols:
- - P. K. Nails Set.
 - - 5/8" x 30 Rebars Set.
 - ⊗ - 3/4" Iron Pipe Fd.
 - ⊠ - R. R. Spike Set.

1P

INDEXED ON MAP
8729

King Survey
 Lots No. 1415-1416
 Chippewa Park Allotment No. 3
 Stokes Township
 Logan County, Ohio
 June 22, 1992

Daniel E. Gilbert
 DANIEL E. GILBERT, P.S.
 REG. SUR. NO. 5402
 400 N. PARK ST.
 BELLEFONTAINE, OHIO 43311
 TELEPHONE: 1 (513) 593-1428



Scale: 1" = 40'