
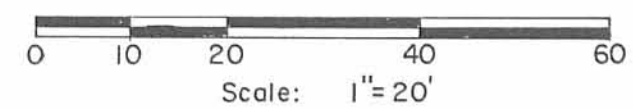


SURVEYORS CERTIFICATION:

I, Daniel E. Gilbert, P.S., Reg. Sur. No. 5402, do hereby certify to National City Bank and Eagle Land Title Co., that on August 23, 1993, that I made an accurate survey of the premises shown on this plat and that there are no visible easements or encroachments on the ground other than those shown. Buildings and other improvements shown were located from actual monumentation found or set as shown.

Daniel E. Gilbert

Daniel E. Gilbert, P.S.
 Reg. Sur. No. 5402
 400 N. Park St.
 Bellefontaine, Ohio 43311
 Phone: 1 (513) 593-1428

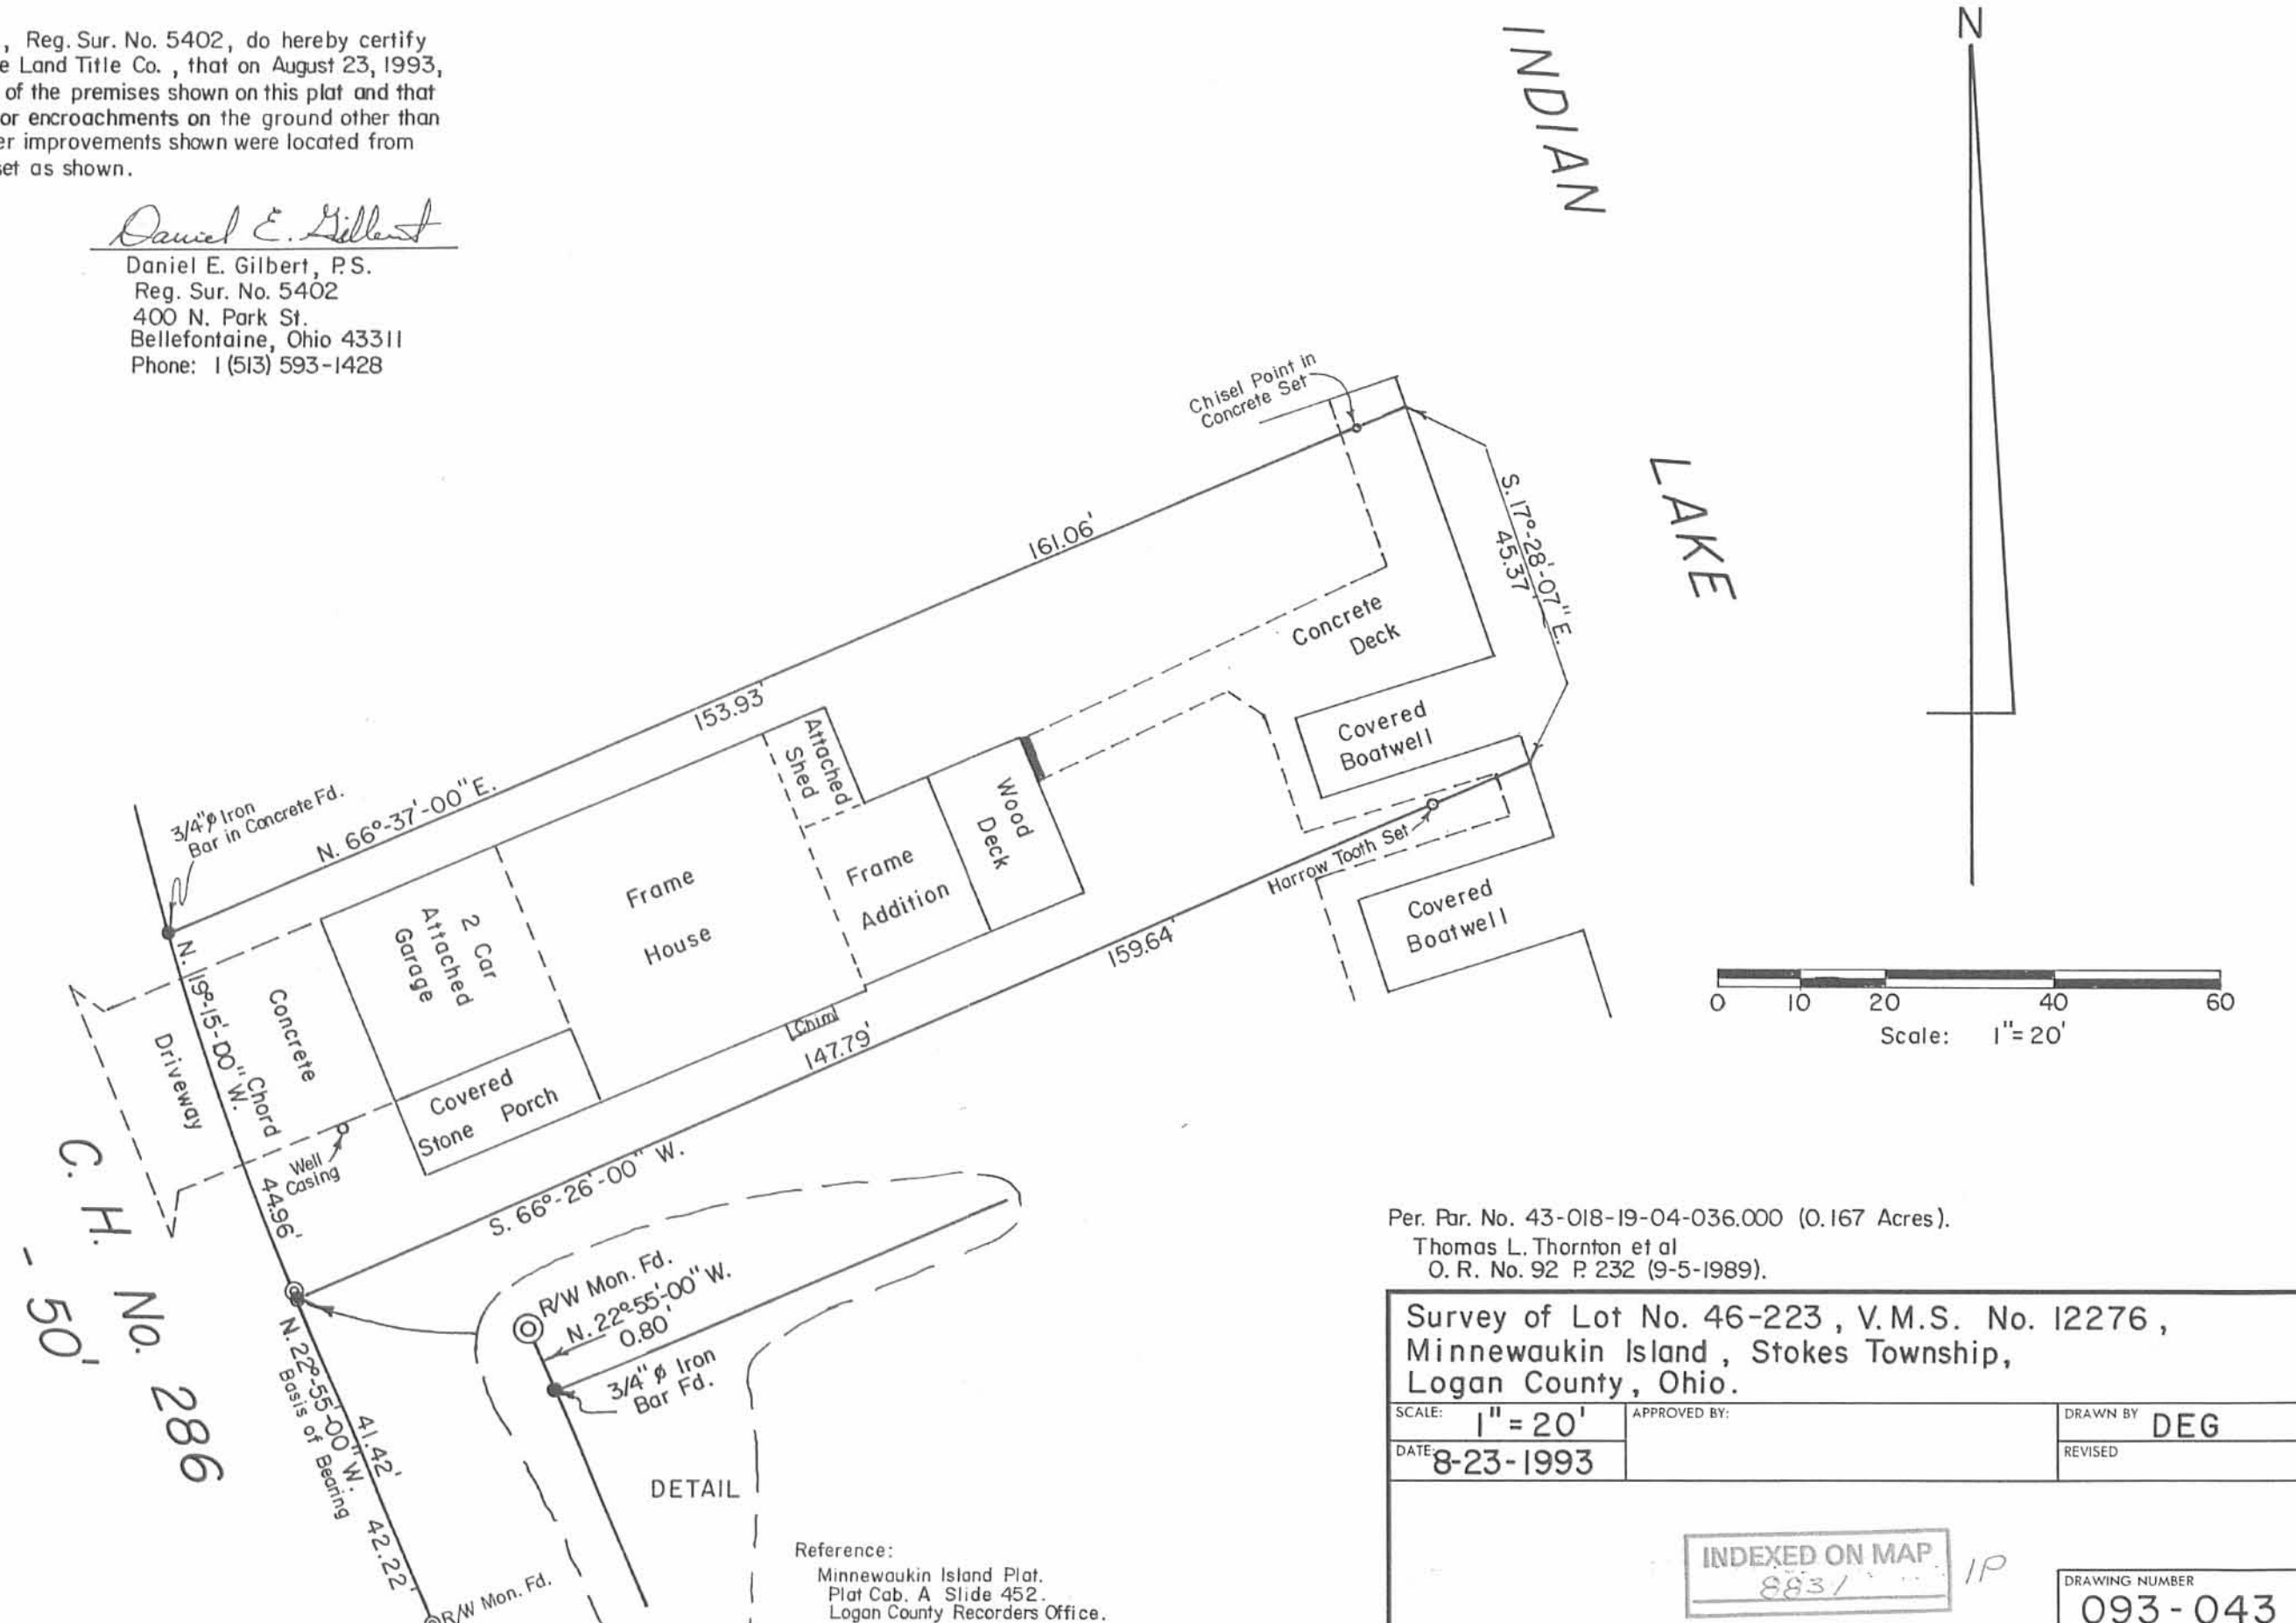

Per. Par. No. 43-018-19-04-036.000 (0.167 Acres).
 Thomas L. Thornton et al
 O. R. No. 92 P. 232 (9-5-1989).

Survey of Lot No. 46-223, V.M.S. No. 12276, Minnewaukin Island, Stokes Township, Logan County, Ohio.	
SCALE: 1" = 20'	APPROVED BY:
DATE: 8-23-1993	DRAWN BY: DEG
	REVISED:
INDEXED ON MAP 8831 IP	
DRAWING NUMBER 093-043	