


LEGEND:
 ○ = 5/8 INCH IRON BAR FOUND
 ● = 5/8 INCH IRON BAR SET



CHINNOCK DRIVE

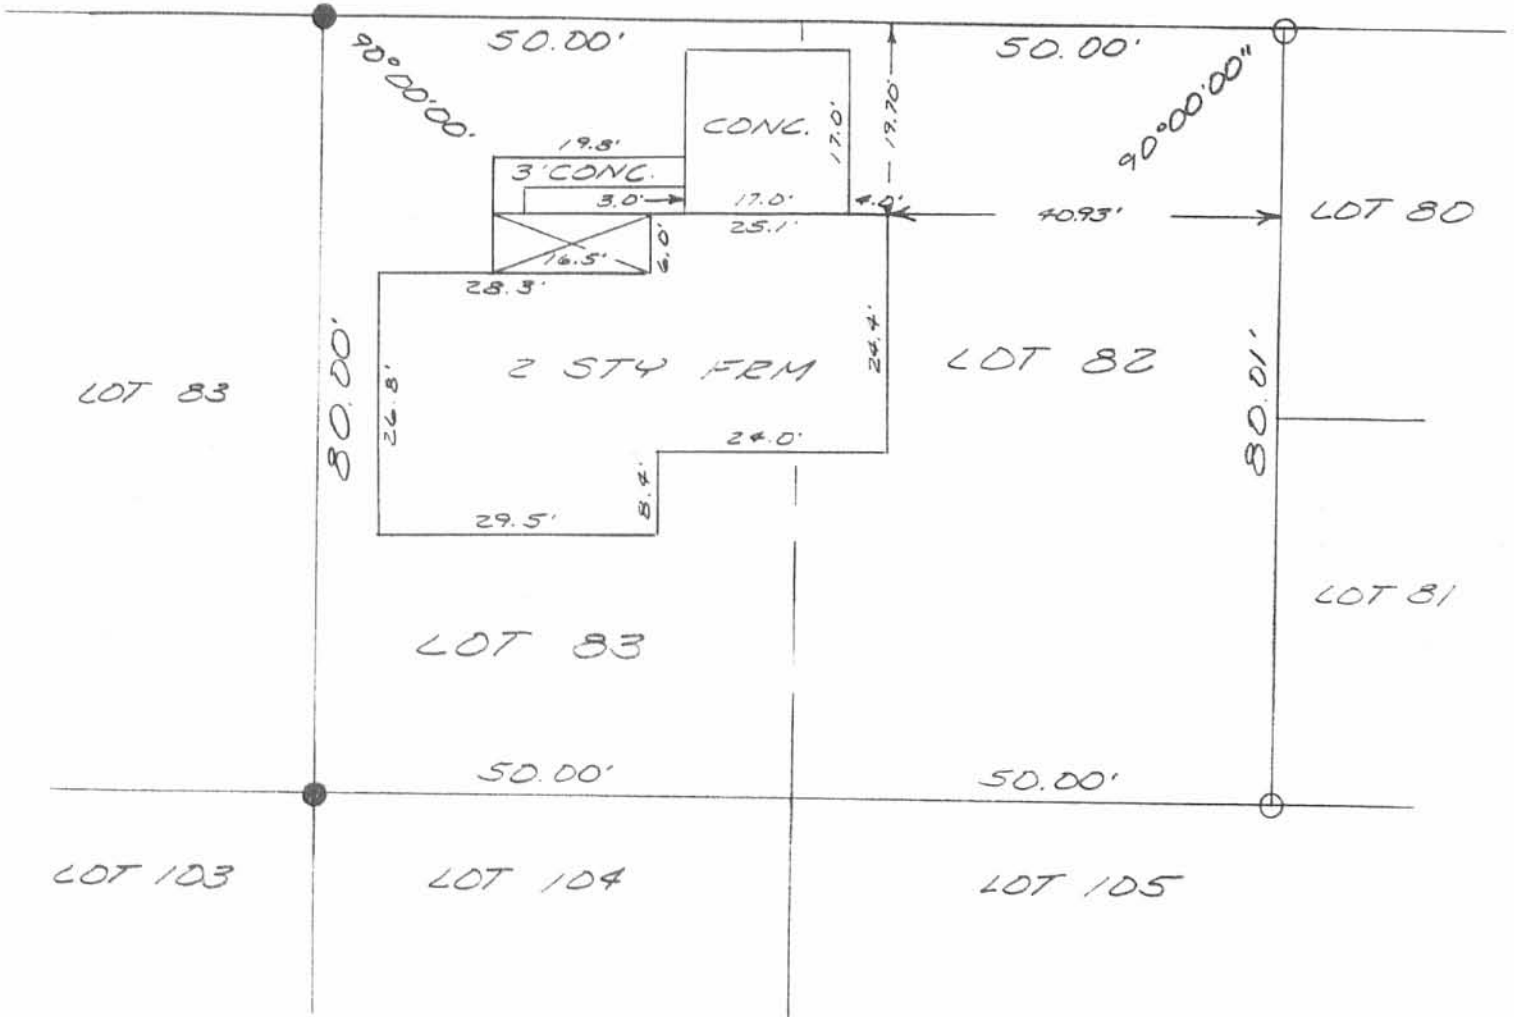

SURVEY OF LOTS 82 AND 83 OF
 SEMINOLE ISLAND IN VIRGINIA
 MILITARY SURVEY 12276, STOKES
 TOWNSHIP, LOGAN COUNTY, OHIO



SCALE: 1" = 20'



INDEXED ON MAP
 8883

1P

Leslie H. Geeslin
 LESLIE H. GEESLIN
 RUSHSVLVANIA, O
 (513) 468-2793