


REC'D 5-6-95 smj


LEGEND:

- ⊙ = 3/4" IRON PIPE FD.
- = 5/8" IRON BAR SET
- ④ = 24" MAPLE

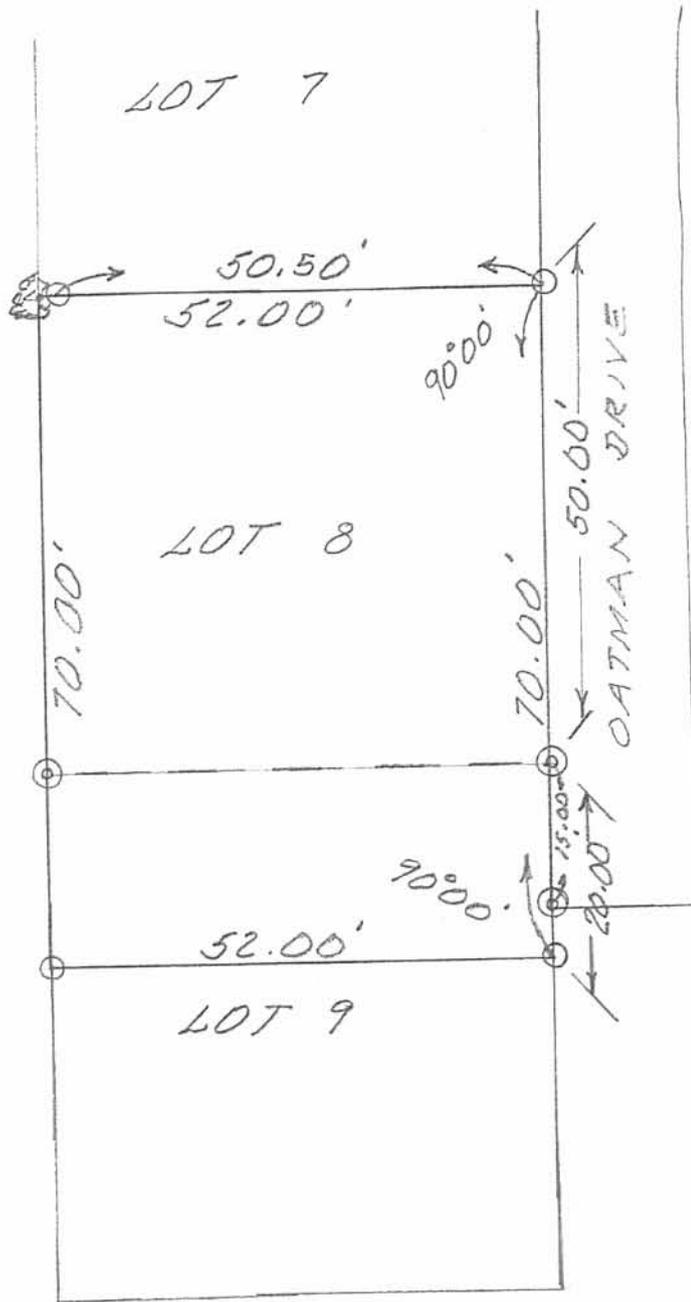

SURVEY OF LOT 8 & THE WEST  
 20.00 FEET OF LOT 9 OF  
 OATMAN'S ALLOTMENT,  
 STOKES TOWNSHIP, LOGAN  
 COUNTY, OHIO FOR  
 KEN BIBLER.

MAY 5, 1995  
 SCALE: 1" = 20'

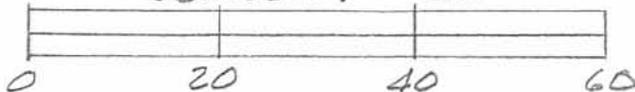

*Leslie H. Geeslin*

LESLIE H. GEESLIN  
 RUSHSVLVANIA, OHIO  
 PH 513-468-2793

INDEXED ON MAP  
 9006

1P