

Lot 38-39-40
 Nichelsons' Island View
 Stokes Twp.

- A = 1" pipe found 145' E. of B - 12" above ground
- B = 1" pipe found - 8" above ground
- C = Evidence of old hub found - ok for dist. (42.0) - 0.5 feet E. of line. Set $\frac{5}{8}$ "[#] Iron where old hub was.
- D = old Hub found - Set $\frac{5}{8}$ "[#] Iron
- E = $\frac{5}{8}$ "[#] Iron set
- F = Evidence of hub found - Set $\frac{5}{8}$ "[#] Iron points F-D-B ok for line
- G = Evidence of hub found - Set $\frac{5}{8}$ "[#] Iron
- H = $\frac{3}{8}$ "[#] Iron set on line G-K
- J = $\frac{3}{4}$ " pipe found - E. of line
- K = $\frac{3}{4}$ " pipe found & used
- L = $\frac{3}{4}$ " pipe found
- M = $\frac{3}{4}$ " pipe found


lots = 42' x 100'

See Plan J-20

INDEXED ON MAP
 9609

Dobson
 McGinnis
 Dobson

May 16, 1956
 Cool - windy 67

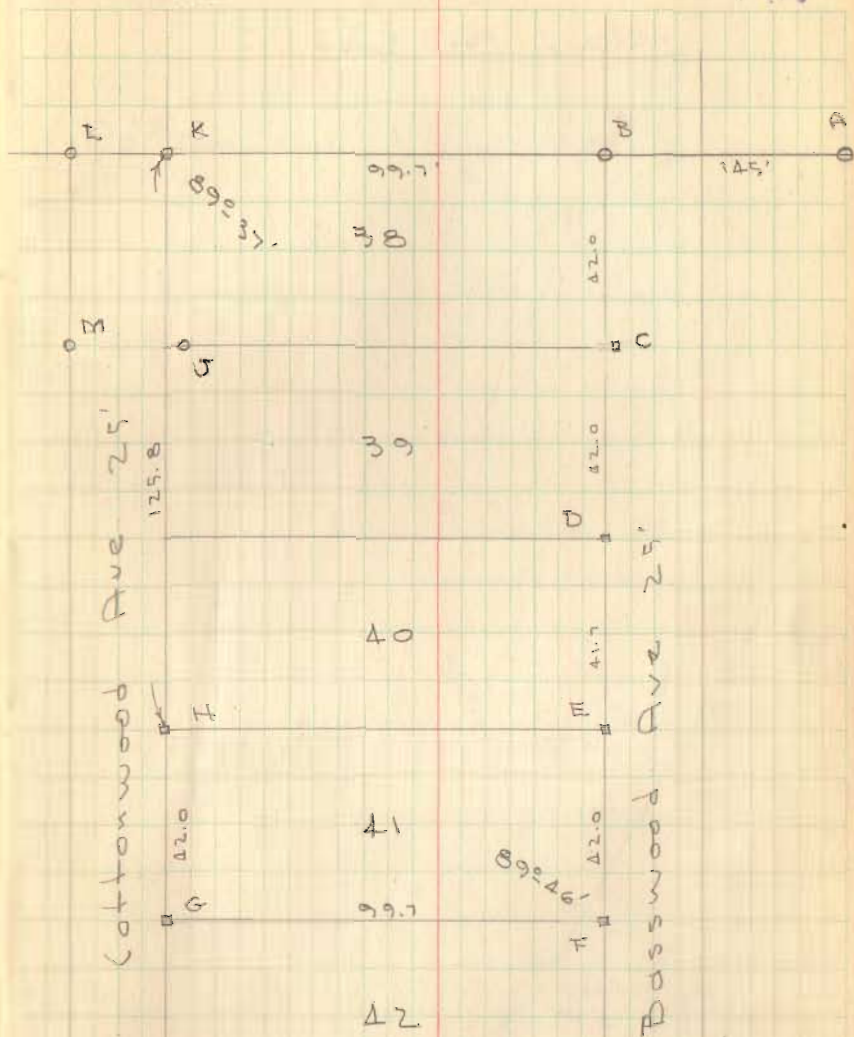

74 581211