


1033 1P

McCracken survey T. 4. R. 13
Union Twp
Sec 12 T4 R13

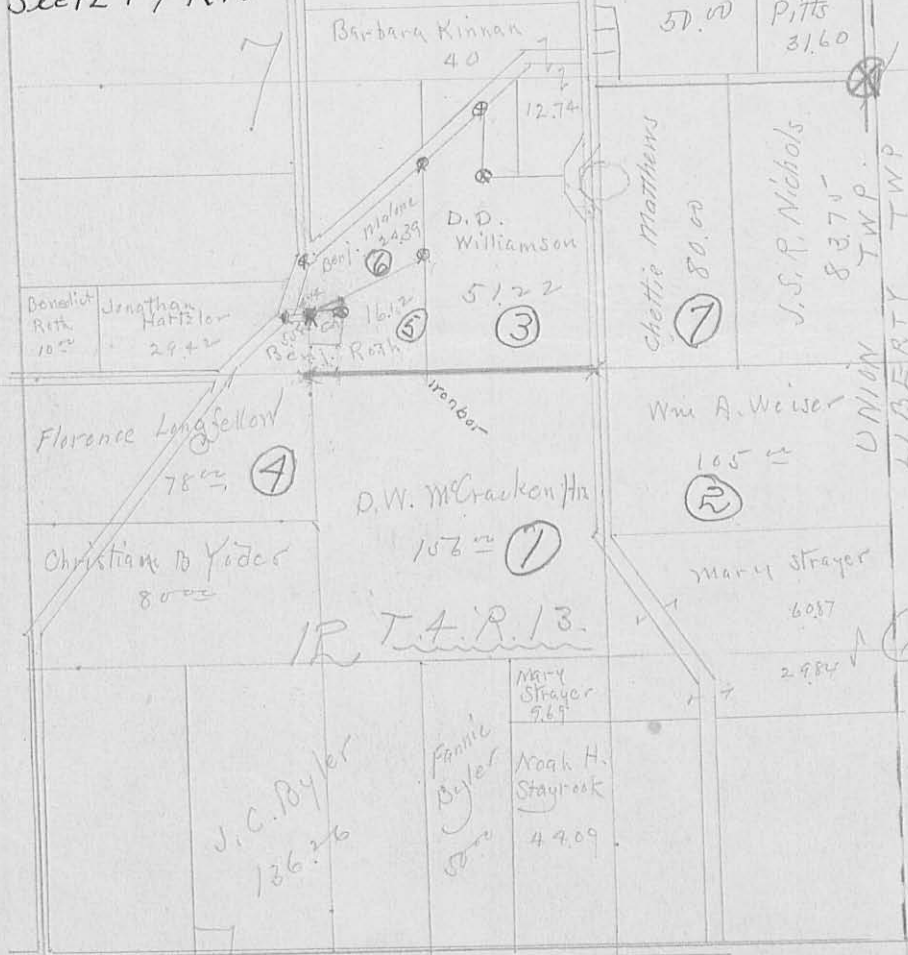

Survey. N. Line Helen McCracken

Plat of the North Line of the lands of


D. W. McCRACKEN, HRS.

Union Tp. Logan Co. Ohio.

Surveyed as shown, Dec. 19, 1911

H. S. Dailey, Surveyor.

Sec. 7. T. 3. R. 14

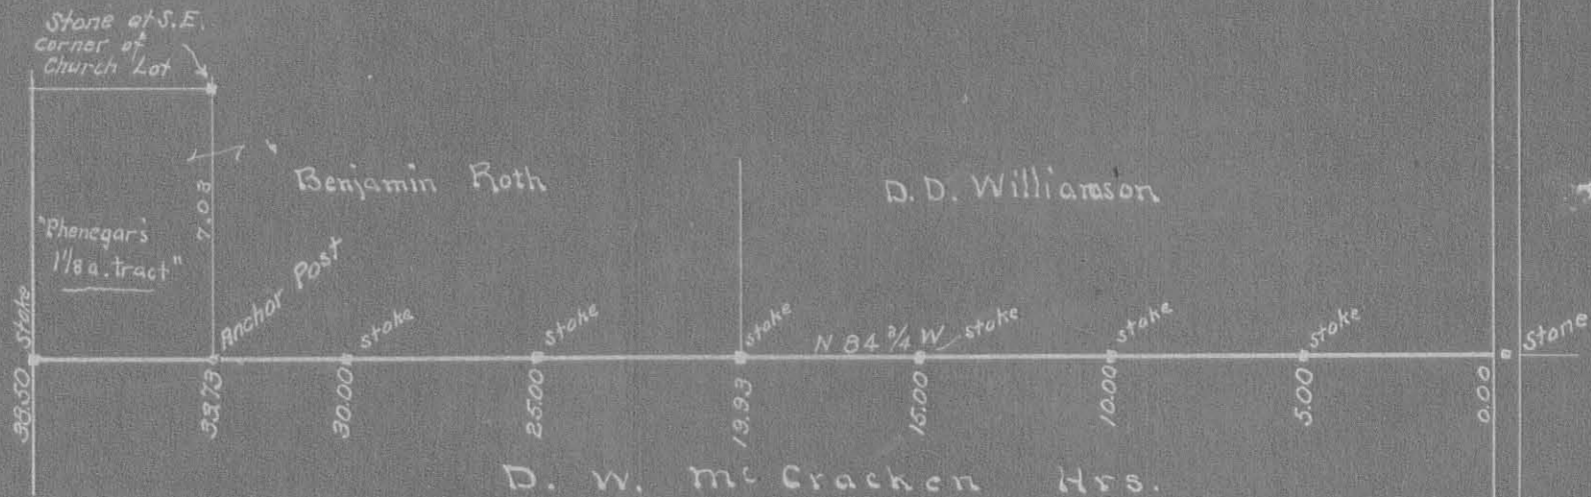

D. W. McCracken Hrs.

Sec. 12. T. 4. R. 13.

INDEXED ON MAP
1033