


1056

SEC. 28, T.4, R. 13.

CO. SURV. RECORD "A." P. 150

9/20/1832, J.W. Marmor.

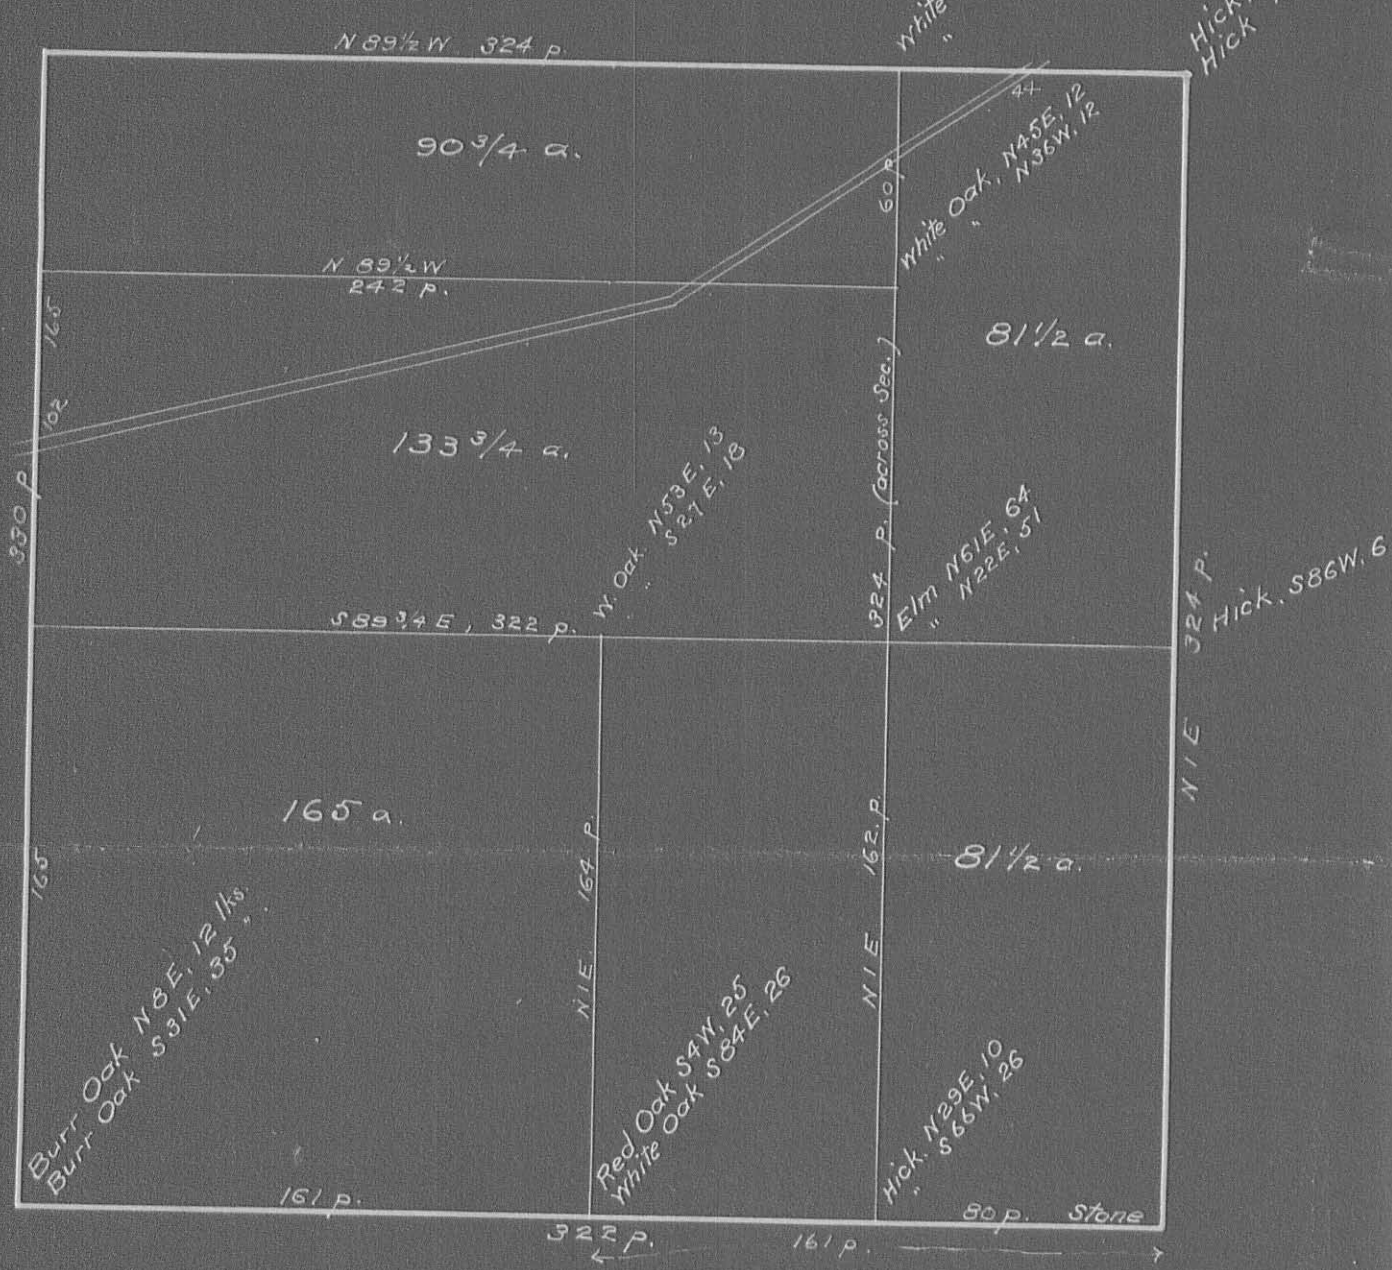

Sec. 28- T. 4. R. 13-

Amelia A. Frick
60

Andrew J. Rausenberger

Fred Mohr

Gabriel Shoemaker
158

Matthias Maier
80

John R. Hanner
79

INDEXED ON MAP
1036