

Road 200
Harrison - Liberty - Lake - Union

30' Sta. 0+00 To 51+79.7


35' Sta. 51+79.7 To 16+19
Road Record 1 Page 66

SEE PAGES 61-62 FOR
ROAD 200 NEAR
ROAD 199

1384
INDEXED ON MAP

June 8-1932

clear
Wright
192
23

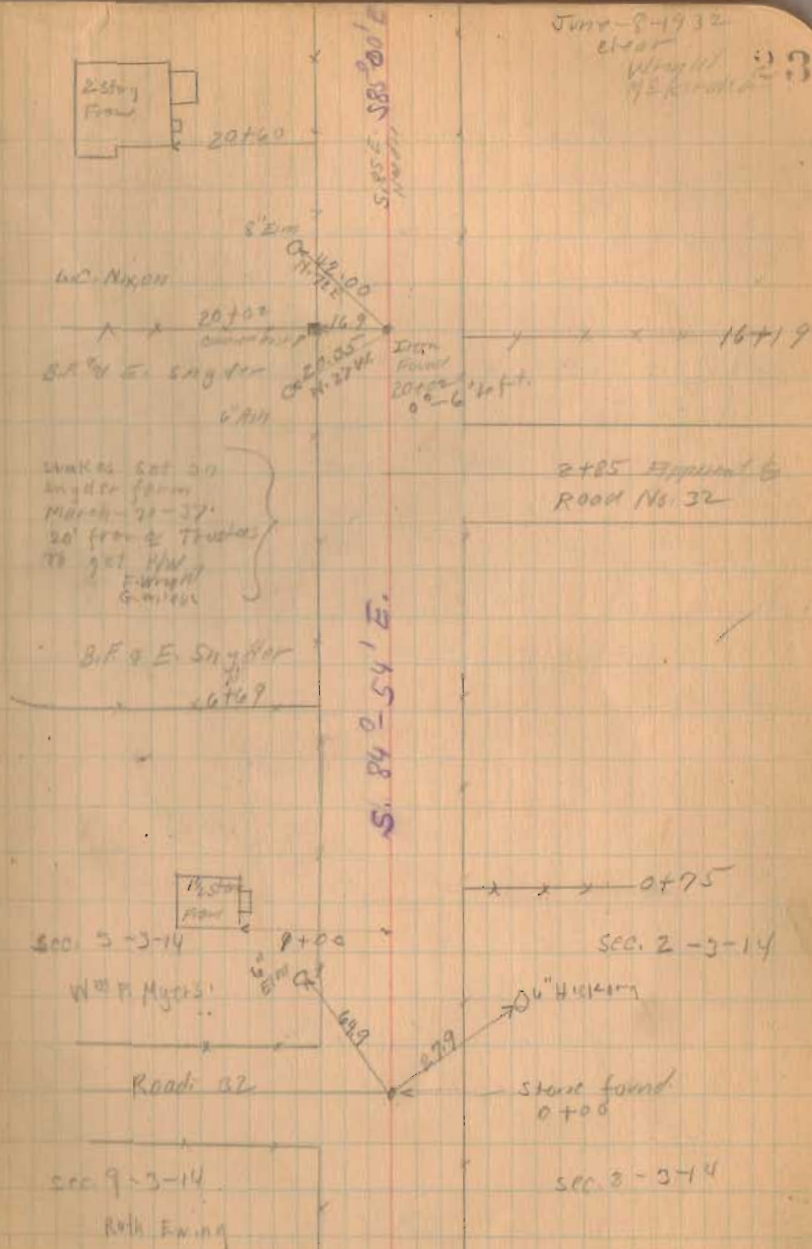

See Pages 77-78-79 for Proposed Title


Road 200

250

1384

INDEXED ON MAP

6/8/22

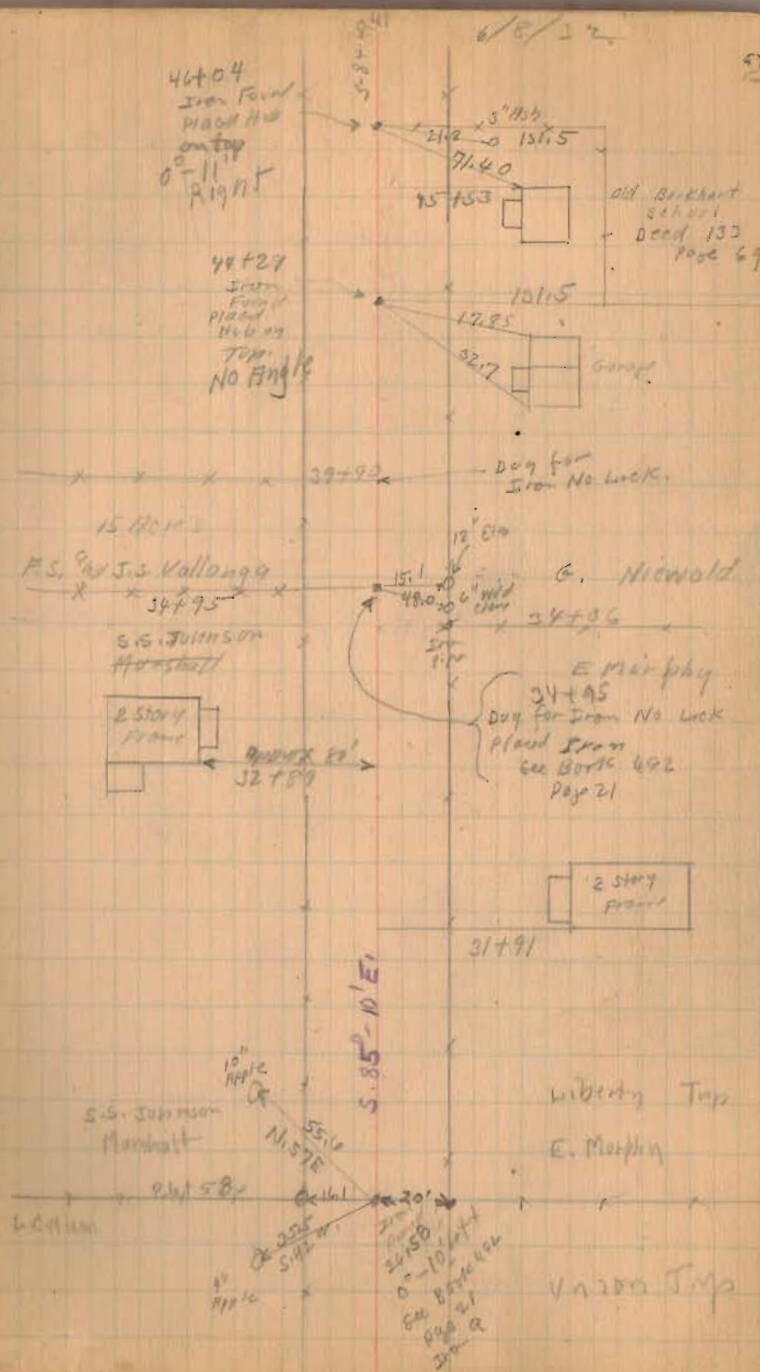

Road. 200


Continued in Book 606. Pages

53706
17221
51783.5

1384
INDEXED ON MAP

6/8/32

25

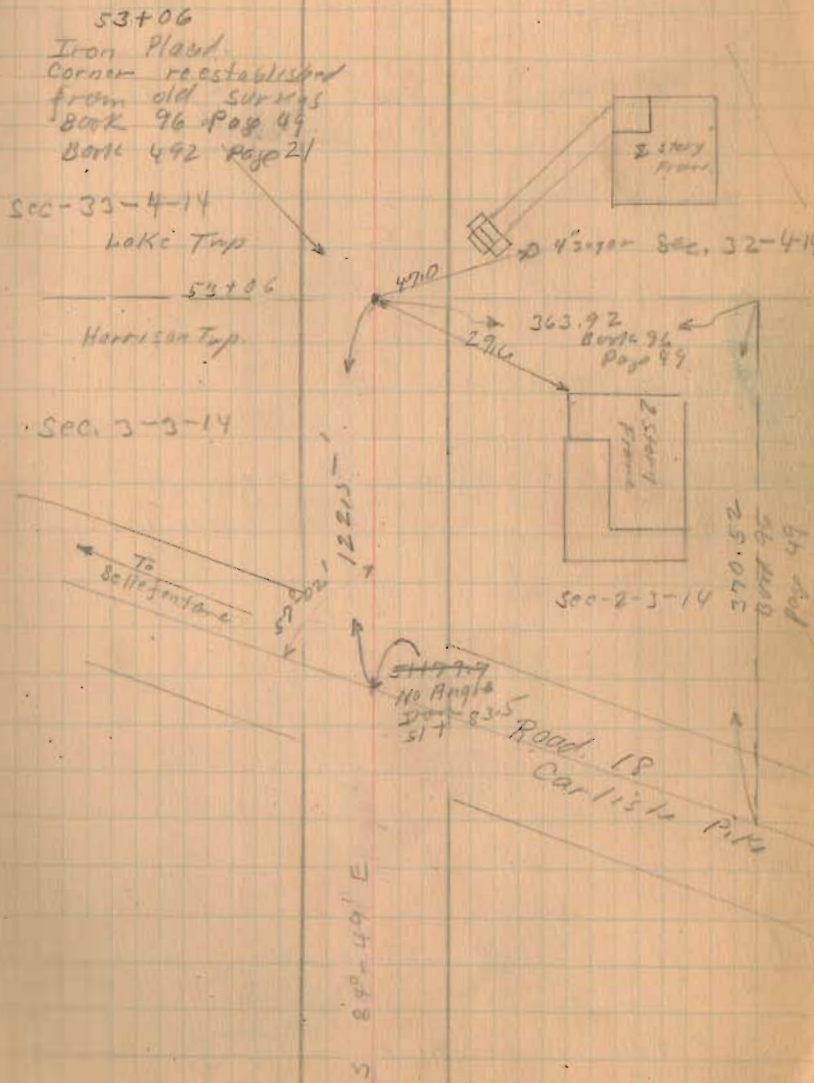

Road 200
Road 198


see page 61

Road 198

1384

INDEXED ON MAP

Descriptions of these in Road 200 File -

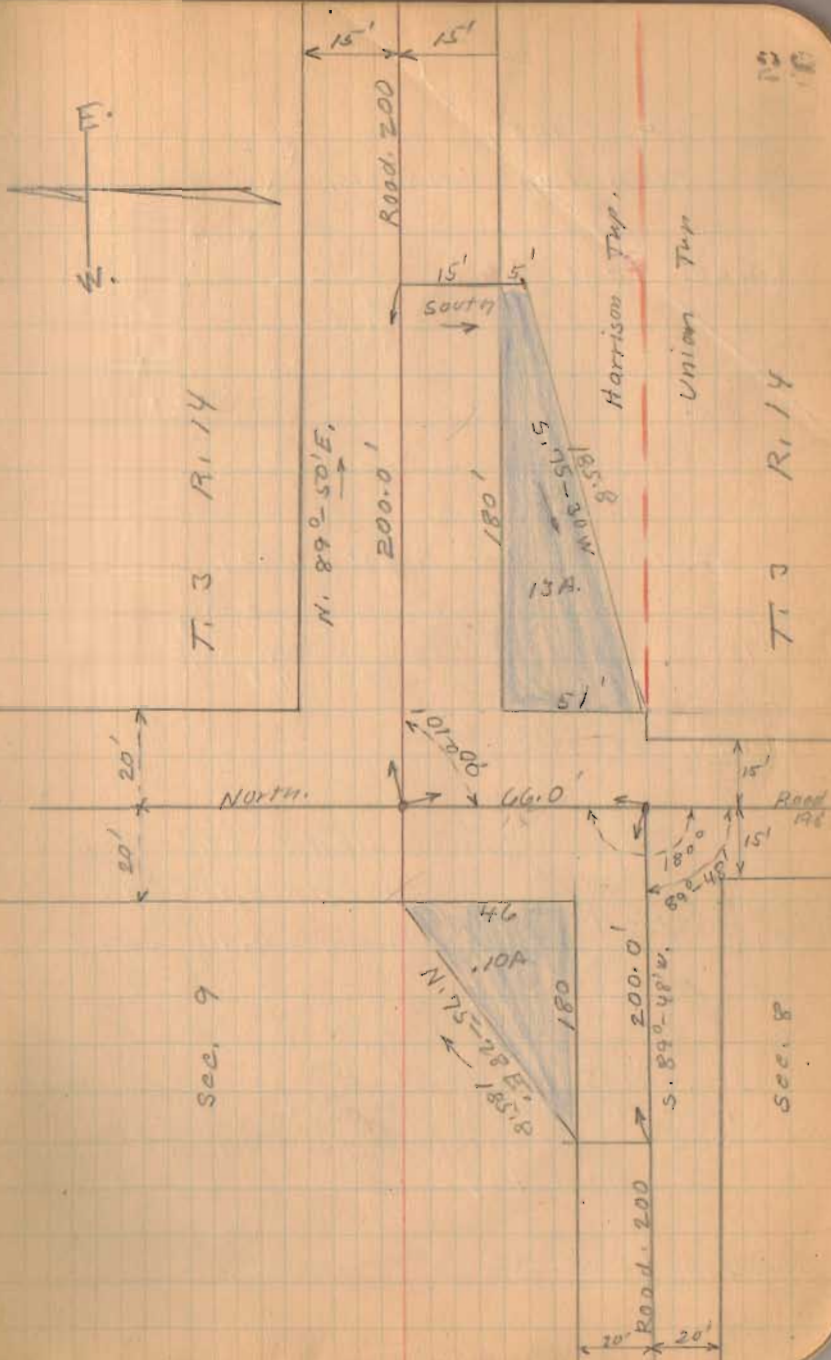

Road. 200
Harrison Twp

stakes Placed 15' from E for 30' Road

stakes Placed from jog at
Downing S.E. cor To top
of Hill near Lane
No Distances TAKEN

See Reed Road Book 49
see Map Road Record 2
Page 511
see Book 597 Page 61

See pages 23 To 25 for
Road 200 East TO
Cartise Pile

1384

INDEXED ON MAP


XAY Straight Line 180°

AX = 100'

AY = 66'

Nov. 9, 1933
Cold Wind
snowing
Wright
M. Miller

61

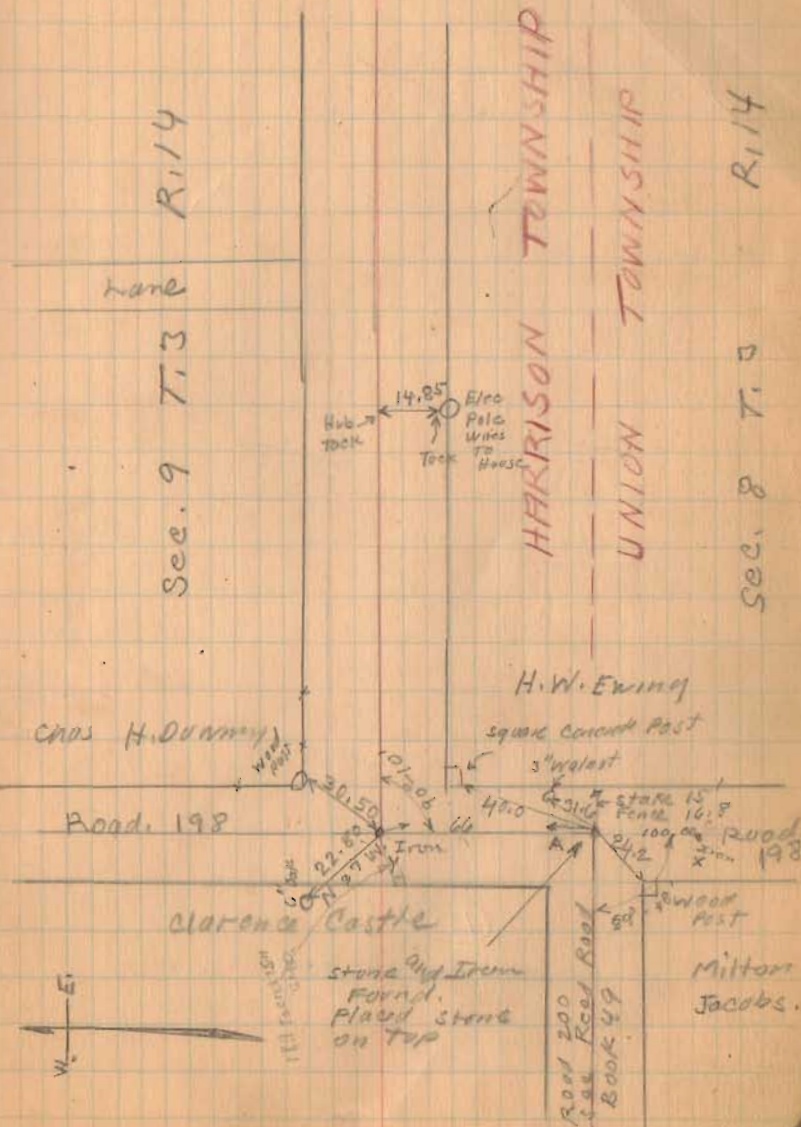


Road, 200

(1384)
INDEXED ON MAP

11-9-32

62

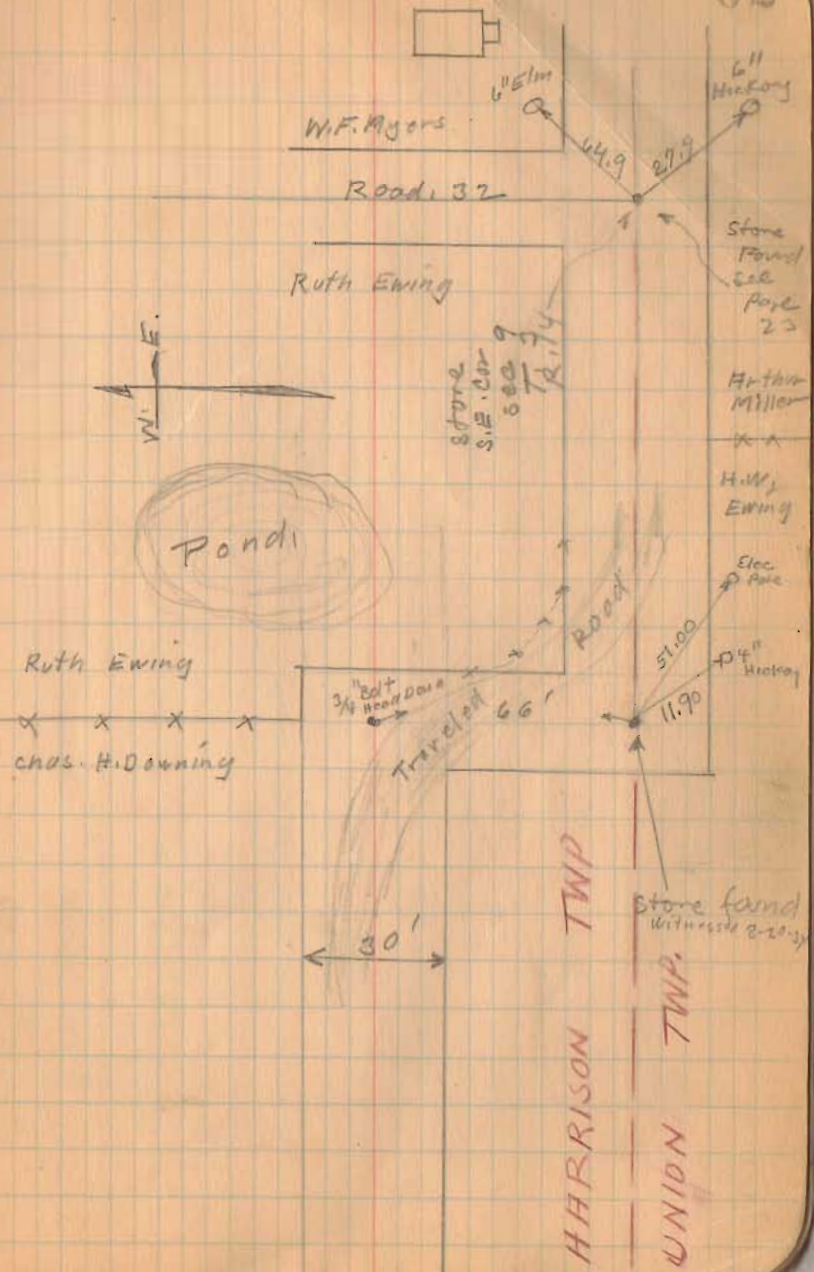

Road 200

Continued from Book 561 Page 25


35' Carlisle Pike to S.H. 189

staked 40' Trusse to get
Right-of-way.

1384

INDEXED ON MAP

March 28, 1938. 5
New day
F. Wright
G. Wilcox
Bob Kinnard
Don Hamilton

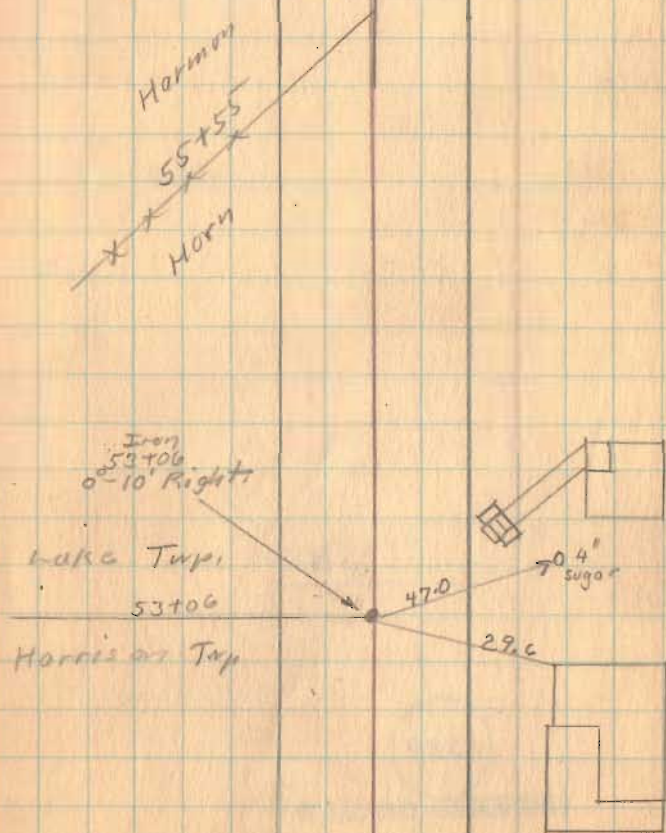

Road 200

Lyle

Harmon



x x 66+34

x 66+23

Harmon

Harmon

24" corr 59+66

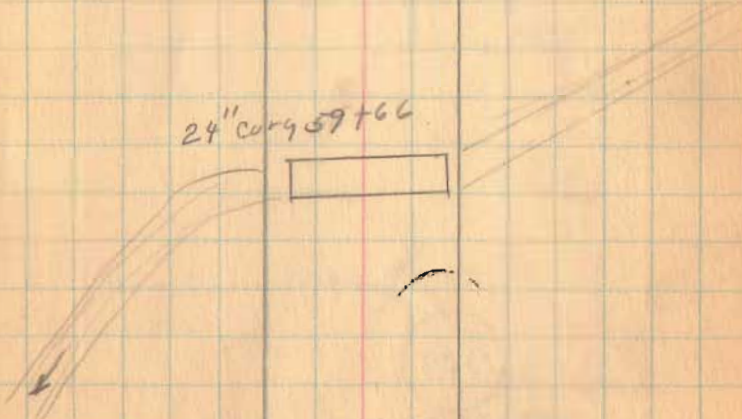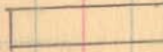

1384

INDEXED ON MAP

1-10-39

G. Wilgus
A. Phillips
J. Davis
A. F. ...

Stakes set 20' R. & 20' L.

Road. 200

77+00

76+00

75+00

74+00



73+00

1384

INDEXED ON MAP

3-28-38

75+77'

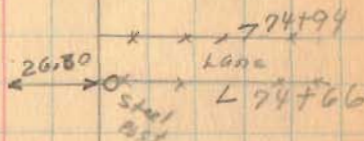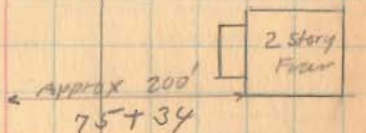

74+00
Division
of maintenance

MEET
HUB

20' MEET
HUB

72+87

Harmon's

HUB

72+66
0° 25' Right



