


Part Lot # 112
DeGraff, Ohio

Lot 112

Walker St.

Lot 100

□ = head bolt found

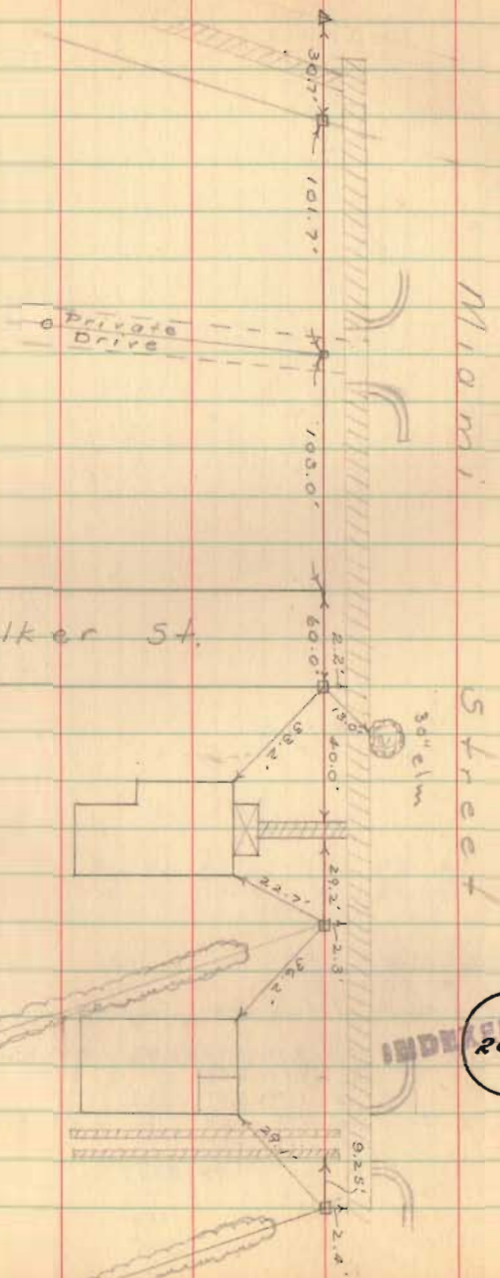


INDEXED ON MAP
2077

D. Dodson
V. Detrick

Mar. 28, 1953

Cool & rain 77

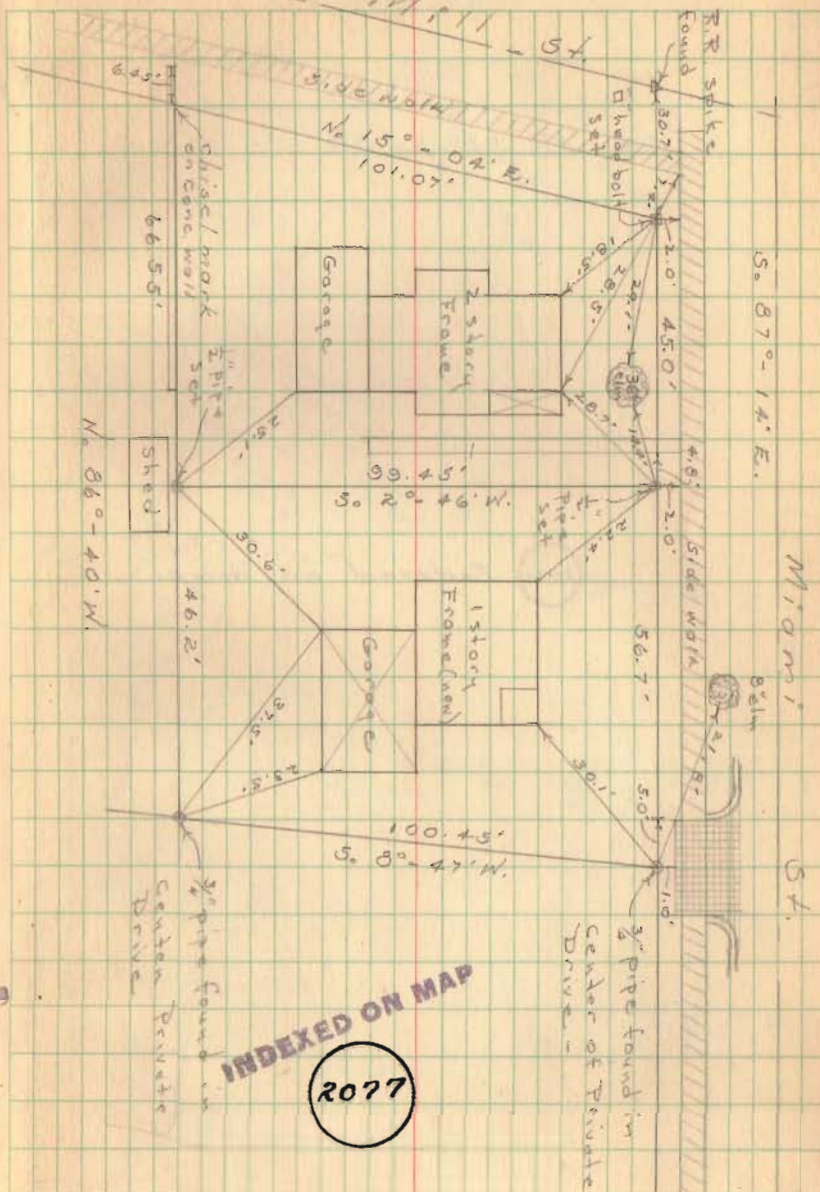

INDEXED ON MAP
2077