

Intersection of Road 43 - Road 198




Stamped Nov. 19 1942 R.H.R.

Scimakep  
F. Hurst  
R. H. Garvey  
9-15-42

9

Rd 43 -  $\frac{1}{4}$  Cor 7, 8 T3 R14  
Found stone on top of large  
boulder with broken brick around  
Set concrete 11mm 4" below surface

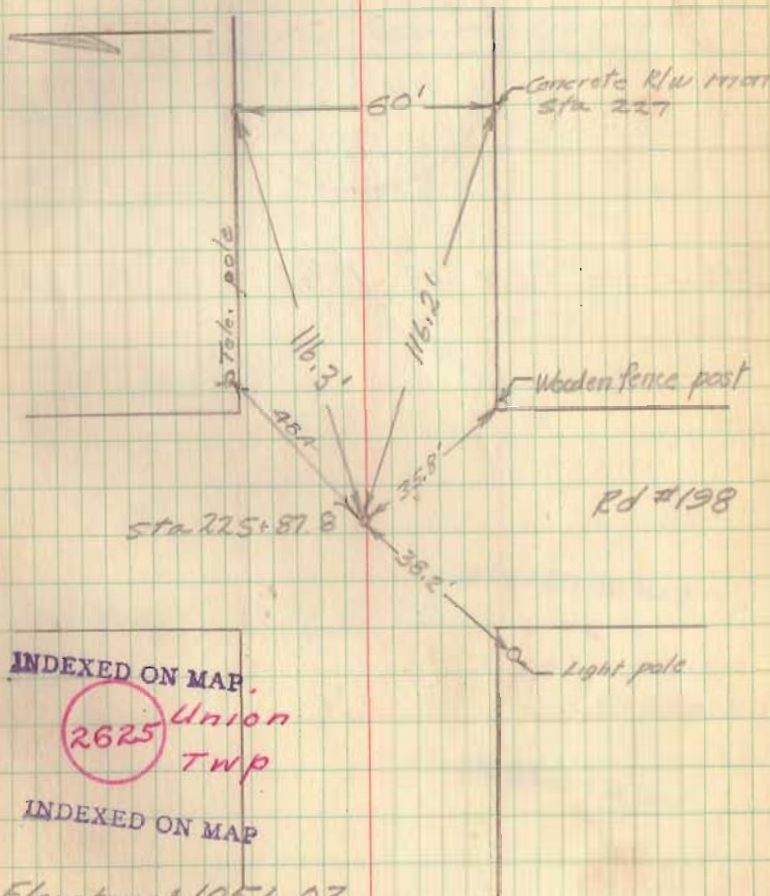

INDEXED ON MAP.

2625 Union  
Twp

INDEXED ON MAP

Elevation: 1056.03