

SECTION CORNER at SEBART - EWING LINE




Stamped Nov 19 1942 R.H.R.

Glinskup  
F. Hurst  
R. McGarvey  
9-16-42

10

Rd 43 Cor 7, 8, 13, 14 T3 R14  
Found stone on top of large  
boulder with broken brick around  
Set concrete mark 5" below surface

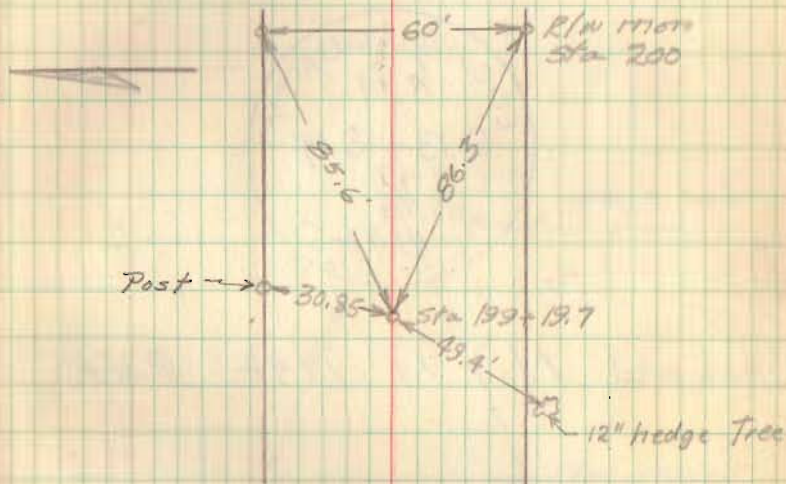

Elevation: 1139.57

INDEXED ON MAP

2526 Union  
Twp

INDEXED ON MAP