

1/4 corner at Horn + Golladay line




Stamped Nov. 13 1942 RMR

GC/MSKcap
FHurst
R. M. Garvey 15
9-18-42

Rd 43 - $\frac{1}{4}$ cor 25, 1/4 T3 R14

Found 4 iron peg on RLW line
and set iron by intersection - 170
other evidence found. Mon 4" below
surface.

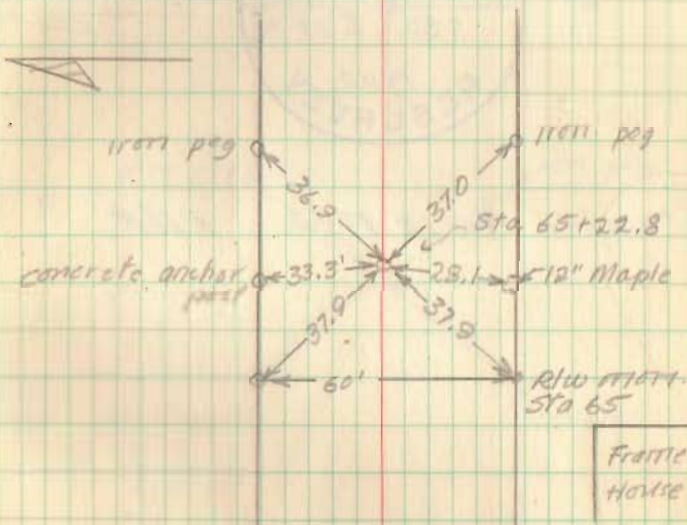

Elevation: 1034.64

INDEXED ON MAP

2631

Union
Twp.

INDEXED ON MAP