

(8)

10-11-44
Dyert
Robbins
M. Adams




Found Stone. Referred To in
Book 558 p. 63
Removed same and placed Concrete
Men. Full (4') length
Top 10" below surface of Road
marked as above

See Book 558 page 63

3

Ed. 10 July 1972 c.N.

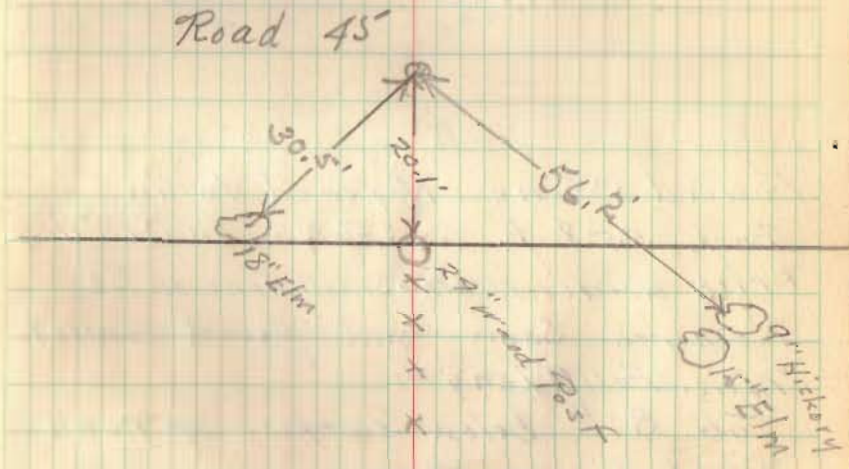

INDEXED ON MAP

2645 Union
Twp.

INDEXED ON MAP