


10-12-44

Insert
Dickinson
B. Wilgus

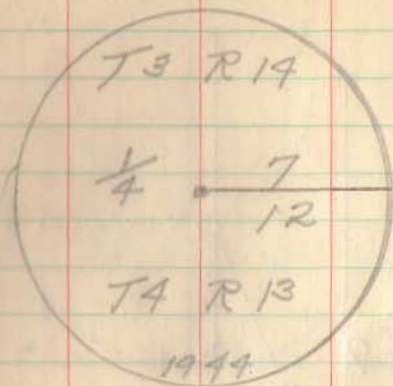

Found stone and Bricks as
referred to in Field Book 558
p. 69

Removed same and placed
Concrete Mon. Full length
6" above ground
Marked as above

39.4
8' mid (height)

