

10-18-49  
Dysert  
Dickinson  
R. Wilgus




See Book 575 page 39

Found stone on end with broken bricks and  $1\frac{1}{2} \times 2 \times 29$ " wood stake under stone 2' deep.

Removed and placed Concrete Mon.  $3 \times 2$ " Long.

Top 10" below road 33 marked as above

"Reason for Cutting Monument,"  
20" to 24" tile ditch 4' below surface of road under North Edge of Monument. Running E. by West

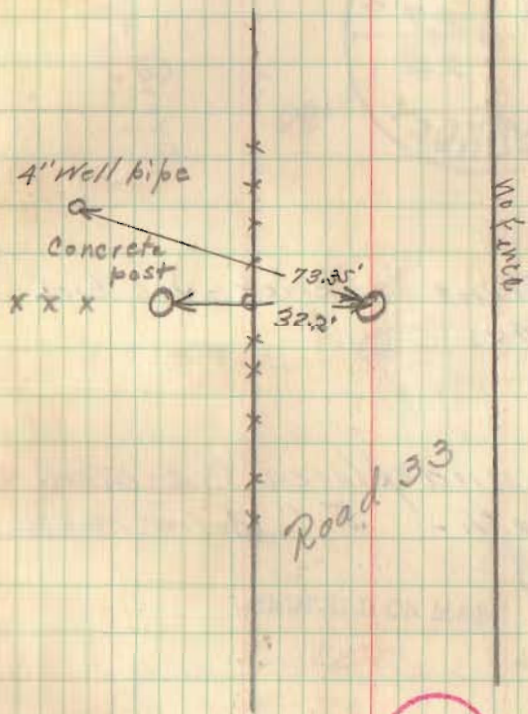

Pleasant Twp.

2658

Union Twp

✓