




4/30/43

Found blue stone 6" x 10" x 15" resting on top of large boulder. The blue stone was removed and the monument 11" from the top. The mon. rests on the boulder and is in approx. 9 in. of concrete.

J. H. Inskeep
Lane Kerns
Paul Fout

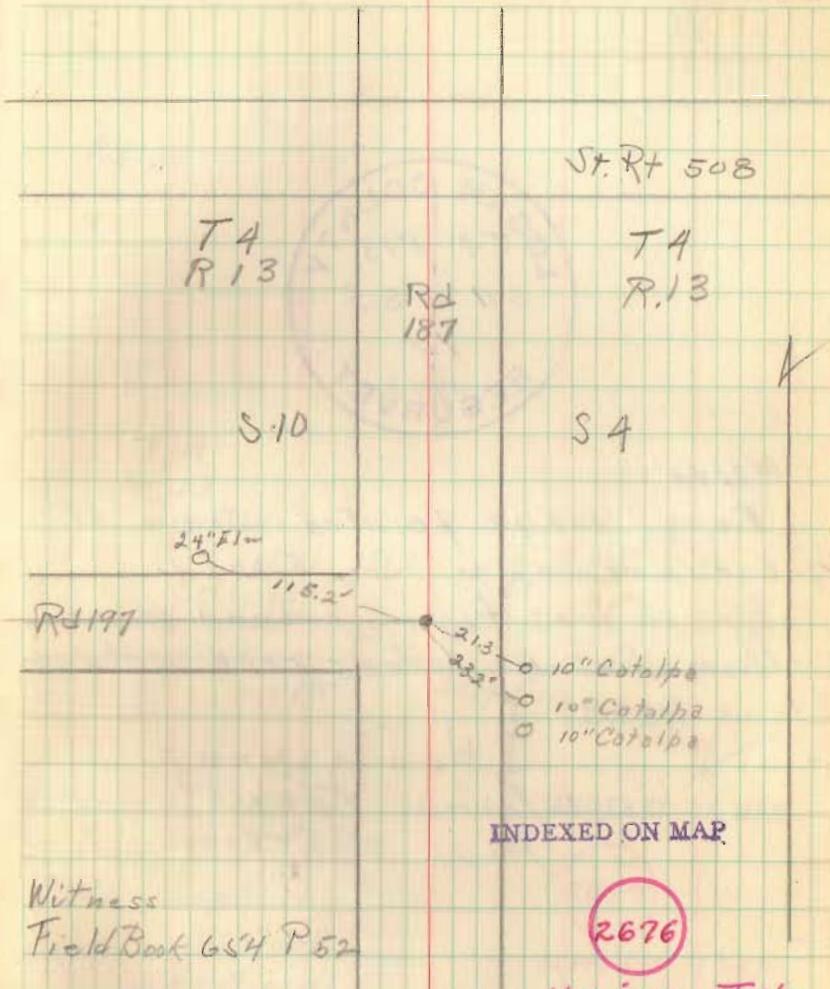

INDEXED ON MAP

Witness
Field Book G54 P52

2676
Union Twp.